

KANSAS

O. W. P. B.


FORM 51 5M 1-42 PETROL

Barton

Section 34 Township 20 Range 14W

Well No. #2 Pritchard

Company Texas

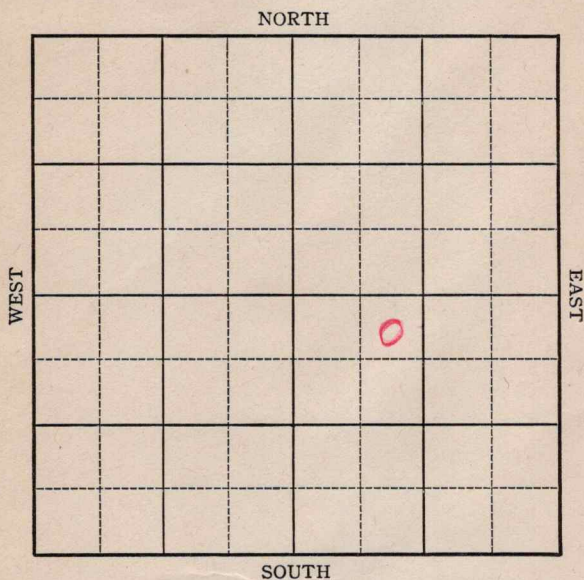

KANSAS

O. W. P. B. KANSAS
Barton

Sec. 34 Twp. 20 R. 14W ✓

Well No. #2 Pritchard Farm

Texas Company Company

Pritchard


330 Ft. from N. Line

 Ft. from S. Line

 Ft. from E. Line

990 Ft. from W. Line

Elev. 1908

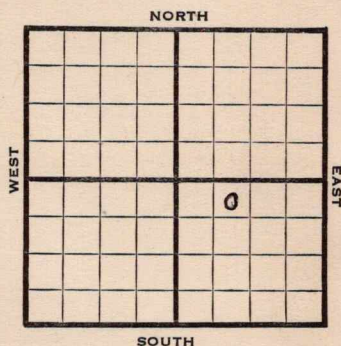

1944

REPORT

7/19	Location
7/26	8" @ 802 WOC
8/2	Drlg. 2745
8/9	Lans 3294
	Drlg. 3404
8/16	BMC 3526 5" @ 3554
	TD 3564 RUST
8/23	TD 3564 swb 35 oil in 23 hrs.
8/30	" " " " " " " "
9/8	" " " " " " " "
9/13	Lans 3278
	BKG 3504
	Simp. 3545
	Arb. 3553
	5" @ 3554' corrected
	TD 3564'
9/20	Arb. 3553
	5" @ 3554
	Pump 55 Pot.
	TD 3564'
	Grav. 36.4

COMPLETED

OVER

1951
10/31

O. W. P. B. 750511

BL 3268'

Lans 3278'

B KC 3504'

Simp 3545'

Arb. 3554'

OTD 3564' 5" @ 3554 was Ab prod.

PB 3536' 16/3525-29

65 BOPD plus 86% W.

Completed.

FIRST REPORT

✓

COMPLETED

Pool Name PritchardMap No. KANSAS Sec. 34 Twp. 20 R. 14WWell No. 2 PritchardTexas

Company _____

FIRST REPORT

Contractor _____


NE NW SE

SECTION PLAT

330 Ft. from N. Line

_____ Ft. from S. Line

_____ Ft. from E. Line

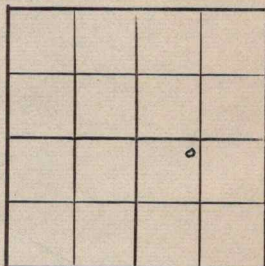990 Ft. from W. LineBarton CountyLocation X

Rig up _____

Drilling and Remarks:

RECORD

Cased _____ in., _____ ft.

Sand _____

Gas _____

Oil _____

Total Depth _____

PRODUCTION

1st 24 hrs. Nat. _____

1st 24 hrs. after shot _____

Gas _____ Cu. Ft.

Dry Hole _____

Abandoned _____

Date

JUL 1 9 1944

19

S. J. LEWIS

Scout

KANSAS

Pool Name Pritchard PoolMap No. 82 Sec. 34 Twp. 20 R. 14WWell No. 2 PritchardTexas


Company

COMPLETED

Contractor

NE NW SE

SECTION PLAT

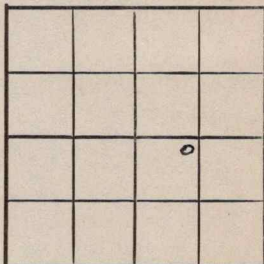330 Ft. from N. Line Ft. from S. Line Ft. from E. Line990 Ft. from W. LineBarton CountyLocation Rig up

Drilling and Remarks:

Cor 835535-1103554Pay 5588864

RECORD

Cased in., ft.Sand Gas Oil Total Depth 3564

PRODUCTION

1st 24 hrs. Nat. 1st 24 hrs. after shot Gas Cu. Ft.Dry Hole Abandoned

Date

SEP 20 1944 19S. J. LEWIS Scout

County **Barton** State **Kansas**
 Sec. **34** (Blk.) **20** (Sur.) **14W** Map No.

Operator **Texas**

Well No. **2** Farm **Pritchard**

Elev. Location **NE NW SE**

FIRST REPORT

COMPLETE

330 Ft. From **N** Line **SE**

990 Ft. From **W** Line Quarter

1st. Report **OCT 31 1951**

Completion **OCT 31 1951**

Remarks **OWPB**

O. W. P. B.

Spudding Date

Drlg. Data

BL 3268 Lans 3278 BKC 3504 Simp 3545

Arb 3554 OTD 3564 5" @ 3554 was ab prod.

PB 3536 16/3525-29 65 Bopd plus 86% W.