




SEC. 16 TWP. 18 R. 1W

WELL NO. 1 Onstott FARM

COMPANY Anderson-Prichard

CONTRACTOR B & B Drlg.

Wildcat  
 \_\_\_\_\_ Ft. from N. Line  
 990 \_\_\_\_\_ Ft. from S. Line  
 990 \_\_\_\_\_ Ft. from E. Line  
 \_\_\_\_\_ Ft. from W. Line

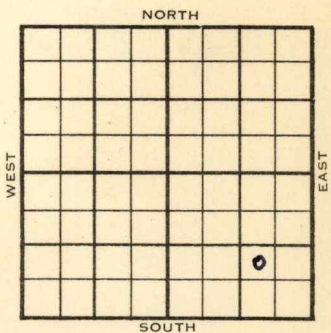

NW SE SE

1954 ELEVATION 1447' REPORT

1/6 Location  
 1/13 8" @ 215'  
 Drlg. 1950'  
 1/20 Lans 2177', Cong 2744', Miss 2764'  
 DST 2766-90', 1 1/2 hrs., 60' vsocm, 130#  
 KH 3013', Htn 3140', Mq. 3162', V  
 3276'  
 Drlg. 3283'  
 1/27 RTD 3295' log  
 5" @ 2844', CO 2808'  
 2/3 Spud 1-7-54  
 D&A  
 TD 3295'  
 8" @ 215'  
 Lans 2177', Cong 2744', Miss 2764'  
 DST 2766-90', opn 1 1/2 hrs., rec. 60'  
 vsocm, 130#  
 Kh 3013', Hunton 3140', Maq. 3162',  
 Viola 3276'  
 TD 3295'  
 5" @ 2844'  
 CO to 2808', CO to 2812', 64/2768-76  
 250A  
 St-frac, S 1/2 bo 108 bw 12 hrs.  
 D&A



County McPherson State Kansas

Sec. 16 (Blk. Twp.) 18 (Sur. Rge.) 1W Map No.

Operator Anders on-Prichard

Well No. 1 Farm Onstott

Elev. 1447 Location NW SE SE



990 Ft. From S Line SE  
990 Ft. From E Line Quarter

1st. Report

Completion FEB 3 1954

Remarks

B & B Drlg. - Contr.

Spudding Date 1-7-54

Drlg. Data D & A TD 3295

8" @ 215 Lans. 2177 Cong. 2744

Miss. 2764 DST 2766-90 open 1 1/2 hr.

Rec. 60' vsocm 130# Kh. 3013

Hunton 3140 Maq. 3162 Viola 3276

TD 3295 5" @ 2844 CO to 2808

CO to 2812 64/ 2768-76 250 A

st-frac S/ 1/2 bo 108 bw 12 hr.

D & A

J. G. McGEHEE