


SECTION 16 TOWNSHIP \_\_\_\_\_ RANGE 1W

WELL NO. #2 Schroeder

COMPANY Bennett & Roberts

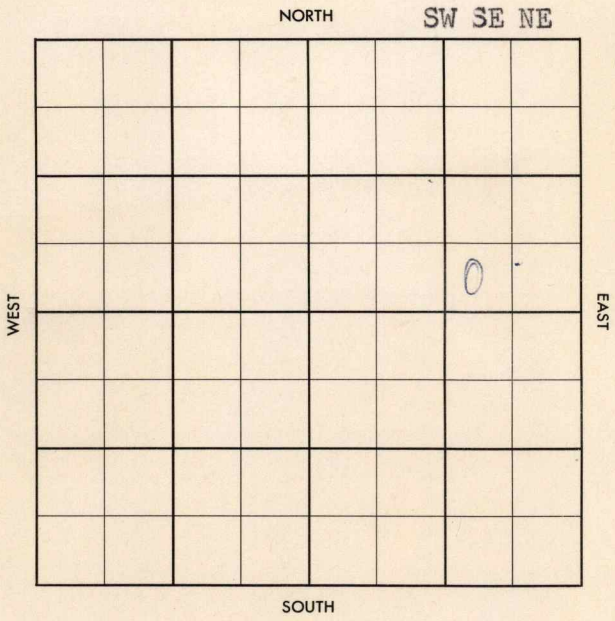

County McPherson Elev. \_\_\_\_\_  
 Sec. 16 Twp. 18 Rge. 1W  
 Company Bennett & Roberts  
 Farm Name Schroeder No. 2


TOPS	DEPTH	LOG	DATUM
Anh.			
TP.			
H.			
Tr.			
Dg.			
Bl.			
L.			
K.C.			
B.K.C.			
Ce.			
C.			
M.			
M.			
K.			
Mz.			
Mq.			
V.			
S.			
S.			
A.			
R.			
Pe.			
G.			
T.D.			

Loc. in Sec. \_\_\_\_\_  
SW SE NE  
 Geol. \_\_\_\_\_  
 Contr. \_\_\_\_\_  
Co. tools  
 Pool \_\_\_\_\_  
Paden

FIRST REPORT	
	o
JUL 10 57	

Date Comm. \_\_\_\_\_  
 Location \_\_\_\_\_

\_\_\_\_\_  
 \_\_\_\_\_  
 \_\_\_\_\_  
 \_\_\_\_\_  
 \_\_\_\_\_

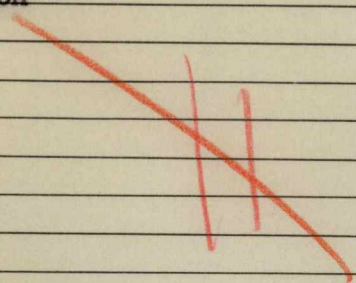

Co.  
Lse.  
No.  
Sec.  
T.  
R.

County McPherson Elev. 1447  
 Sec. 16 Twp. 18 Rge. 1W  
 Company Bennett & Roberts  
 Farm Name Schroeder No. 2

Co.

TOPS	DEPTH	LOG	DATUM
Anh.			
Tp.			
H.			
Tr.			
Dg.			
Bl.			
L.			
K.C.			
B.K.C.			
Ce.			
C.			
M. <u>chert</u>	<u>2767</u>		
M.			
K.			
Mz.			
Mq.			
V.			
S.			
S.			
A.			
R.			
PF.			
G.			
T.D.	<u>2841</u>		

Loc. in Sec. SW SE NE  
 Geol. \_\_\_\_\_  
 Contr. Co. tools  
 Pool \_\_\_\_\_  
 Paden \_\_\_\_\_

Use.

	AUG 21 '57
COMPLETE	

No.

Date Comm.

Location JUL 17 '57 JUL 24 '57 7-19-57  
8 5/8 195 ID 1500 JUL 21 '57 Pipe  
set. AUG 2 '57 DST 2769-77 ip  
30" 2' Md + 550 BHP 200/15"  
DST 2777-92 op 1hr 40'  
HOCM BHP 275/20" 5 1/2 2841  
co PF 25/2784-88 1 8  
10 B0 + 40 BW 1hr Pst AUG 14 '57  
AUG 21 '57 Est 25 B0 + 59 BW PF 2784-88

Sec.

T.

R.