

Section 34 Township 20 Range 11WWell No. 1 Asher "B"Company Cities Service

NORTH

WEST

EAST

SOUTH

0

Barton

KANSAS

SEC.	TWP.	R.
34	20	14W ✓

WELL NO.

#1 Asher "B"

FARM

COMPANY

Cities Service

CONTRACTOR

Barbour Drlg.

Pritchard Pool

Ft. from N. Line


330

Ft. from S. Line

430

Ft. from E. Line

Ft. from W. Line

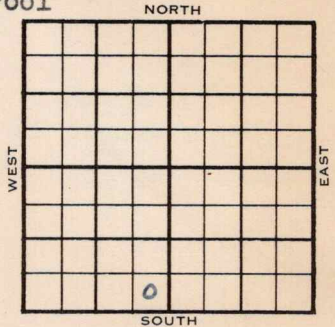

SE SE SW

	ELEVATION	REPORT
1954	1913'	
1/27	R U R	
2/3	8" @ 400' w/200 Drlg. 2960'	
2/10	Top 2895' Dodge 3195' Br li 3279 Lans 3290' DST 3407-20, 1 hr, 60' oil, 205' SM & GCO, 5' MCO 1200# DST 3430-50, 1 hr, 55' M 1050# Cong. 3511 Simp sha 3521' Arb. 3543' RTD 3550' Log 5" @ 3544	
2/17	DD 3551', P/128 bo 13 hrs. P/165 bo 24 hrs.	
2/24	NR	
3/3	NR	
3/10	NR	
3/17	"	
3/24	"	
4/7	Spud 1-26-54 Oil Well TD 3551' 8" @ 400' Top 2895', Dodge 3195', Br. Lime 3279'	OVER

1954

750521

Information brought forward.

4/7

Lans 3290'

DST 3407'-20' opn 1 hr, rec 60' oil
205' sm & gco 5' mco 1200#

DST 3430'-50' opn 1 hr, rec 55' Mud
1050#

Cong 3511', Simp Sh 3521', Arb 3543'

TD 3550'

5" @ 3544'

DD3551'

P/ 128 bo 13 hr.

P/ 165 bo 24 hr.

Comp 391 bopd.

COMPLETED

J. G. McGEHEE

County Barton State Kansas
 Sec. 34 (Blk. 20) (Sur. 14W) (Twp.) Map No.
 Operator Cities Service
 Well No. 1 Farm Asher "B"
 Elev. 1913 Location SE SE SW



330 Ft. From S Line SW
430 Ft. From E Line Quarter
 1st. Report APR 7 1954
 Completion
 Remarks Pritchard Pool
Barbour Drlg. - Contr.
 Spudding Date 1-26-54

Drlg. Data Oil well TD 3551
8" @ 400 Top. 2895 Dodge 3195
Br. lime 3279 Lans. 3290 DST 3407-20
open 1 hr. Rec. 60' oil 205' sm & gco
5' mco 1200# DST 3430-50 open 1 hr.
Rec. 55' mud 1050# Cong. 3511
Simp. sh. 3521 Arb. 3543 TD 3550
5" @ 3544 DD 3551 P/ 128 bo 13 hr.
P/ 165 bo 24 hr. Comp. 391 bopd