


Section 34 Township 20 Range 11W

Well No. 2 Prichard

Company Rocket Drlg.

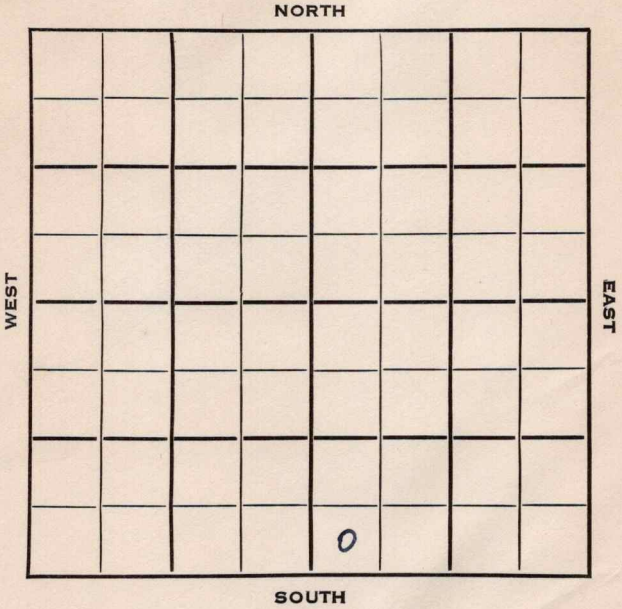

SEC.	TWP.	R.
34	20	14W ✓

WELL NO. \_\_\_\_\_  
 COMPANY 2 Prichard FARM

CONTRACTOR Rocket Drlg.


**Prichard Pool**

\_\_\_\_\_ Ft. from N. Line

330 Ft. from S. Line

\_\_\_\_\_ Ft. from E. Line

330 Ft. from W. Line

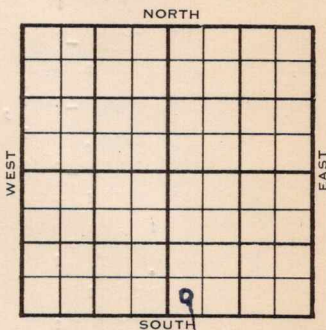

SW SW SE

	ELEVATION	REPORT
1954	1915' RB	

2/3 Spud 2-1-54  
 8" @ 793'  
 Anhy 800'  
 Drlg. 1915'

2/10 Heeb 3171 Br li 3275 Lans 3285  
 DST 3290-3376, 1½ hrs, 310' M, 90' SW  
 980#  
 DST 3401-20, 1 hr, 340' G & MCO, 90'  
 oil, 1040#  
 DST 3450-3525, 1/2 hr, 360' gas, 450'  
 VHly O & GCM, 270' gassy oil, 180'  
 oil, 890# Arb. 3550  
 RTD 3552 5" @ 3551

2/17 Simp. 3514'

2/24 DD 3558' TD  
 FU 2400' oil, 3½ hrs.,  
 S/40 BOPH, POP, P/20 BOPH 11 hrs.

3/3 NR

**OVER**

1954  
3/10

Spud 2-1-54

Oil Well

TD 3558'

8" @ 793'

Anhy 800', Heeb 3171', Br lime 3275',  
Lans 3285'

DST 3290-3376', opn  $1\frac{1}{2}$  hrs., rec. 310'  
mud, 90' sw, 980#

DST 3401-20', opn 1 hr., rec. 340'  
g & mco, 90' oil, 1040#

DST 3452-3525', opn  $\frac{1}{2}$  hrs., rec. 360'  
ga, 450' vho & gcm, 270' gassy oil,  
180' oil, 890#

Arb. 3550'

TD 3552'

5" @ 3551'

Simp 3514'

DD 3558'

FU 2400' oil  $3\frac{1}{2}$  hrs.

S/40 boph P/20 boph 11 hr.

Comp. 1276 bopd

COMPLETED



