

KANSAS

O. W. P. B.


FORM 51 5M 1-42 PETROL

Barton

Section 34 Township 20 Range 14W

Well No. #2 Pritchard

Company Texas

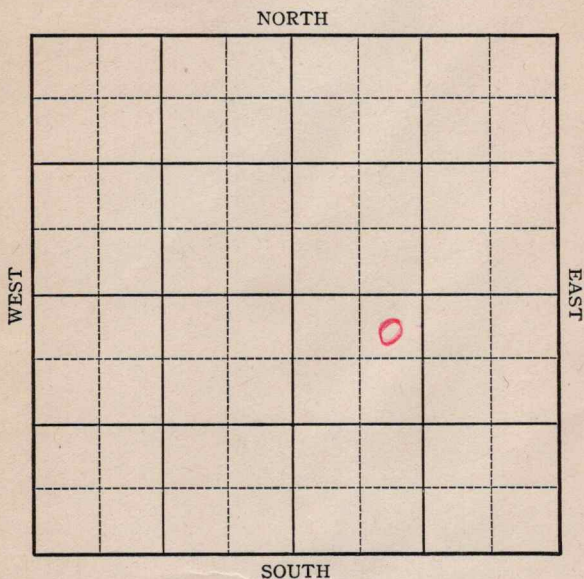

KANSAS

O. W. P. B. KANSAS
Barton

Sec. 34 Twp. 20 R. 14W ✓

Well No. #2 Pritchard Farm

Texas Company


Pritchard

330 Ft. from N. Line

 Ft. from S. Line

 Ft. from E. Line

990 Ft. from W. Line

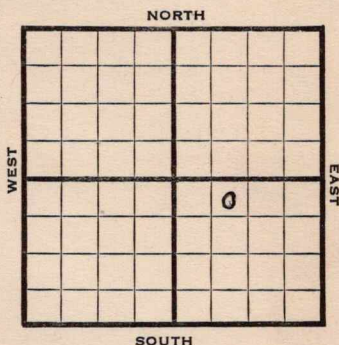

Elev. 1908

1944

REPORT

7/19 Location

7/26 8" @ 802 WOC

8/2 Drlg. 2745

8/9 **Lans 3294**
Drlg. 3404

8/16 **BKC 3526** 5" @ 3554
TD 3564 RUST

8/23 TD 3564 swb 35 oil in 23 hrs.

8/30 " " " " " " " "

9/8 " " " " " " " "

9/13 **Lans 3278**
BKG 3504
Simp. 3545
Arb. 3553
5" @ 3554' corrected
TD 3564'

9/20 **Arb. 3553**
5" @ 3554
Pump 55 Pot.
TD 3564'
Grav. 36.4

COMPLETED

OVER

1951
10/31

O. W. P. B.

750511
750536

BL 3268'

Lans 3278'

B KC 3504'

Simp 3545'

Arb. 3554'

OTD 3564' 5" @ 3554 was Ab prod.

PB 3536' 16/3525-29

65 BOPD plus 86% W.

Completed.

FIRST REPORT

✓

COMPLETED

Pool Name PritchardMap No. KANSAS Sec. 34 Twp. 20 R. 14WWell No. 2 PritchardTexas

Company _____


FIRST REPORT

Contractor _____

NE NW SESECTION PLAT330 Ft. from N. Line

_____ Ft. from S. Line

_____ Ft. from E. Line

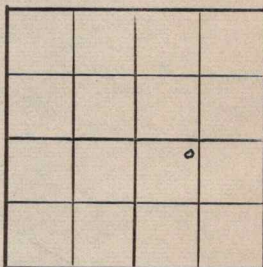990 Ft. from W. LineBarton CountyLocation X

Rig up _____

Drilling and Remarks: _____

RECORD

Cased _____ in., _____ ft.

Sand _____

Gas _____

Oil _____

Total Depth _____

PRODUCTION

1st 24 hrs. Nat. _____

1st 24 hrs. after shot _____

Gas _____ Cu. Ft.

Dry Hole _____

Abandoned _____

Date

JUL 19 1944

19

S. J. LEWIS Scout

KANSAS

Pool Name Pritchard PoolMap No. 82 Sec. 34 Twp. 20 R. 14WWell No. 2 PritchardTexas

Company

COMPLETED

Contractor

NE NW SE

SECTION PLAT

		o	

330 Ft. from N. Line Ft. from S. Line Ft. from E. Line990 Ft. from W. LineBarton CountyLocation Rig up

Drilling and Remarks:

Per 435535-110355-4Pump 55 28364 1/2

RECORD

Cased in., ft.Sand Gas Oil Total Depth 3564

PRODUCTION

1st 24 hrs. Nat. 1st 24 hrs. after shot Gas Cu. Ft.Dry Hole Abandoned

Date

SEP 20 1944 19S. J. LEWIS Scout

County Barton State KansasSec. 34 (Blk.) 20 (Sur.) 14W Map No.Operator TexasWell No. 2 Farm PritchardElev. Location NE NW SE

FIRST REPORT

COMPLETED

330 Ft. From N Line SE990 Ft. From W Line Quarter1st. Report OCT 31 1951Completion OCT 31 1951Remarks OWPBO. W. P. B.

Spudding Date

Drlg. Data

BL 3268 Lans 3278 BKC 3504 Simp 3545Arb 3554 OTD 3564 5" @ 3554 was ab prod.PB 3536 16/3525-29 65 Ropd plus 86% W.

J. E. TYRA