


Section 18 Township 21 Range 5WWell No. #1 NeufeldCompany Stag Drlg.

NORTH

WEST

EAST

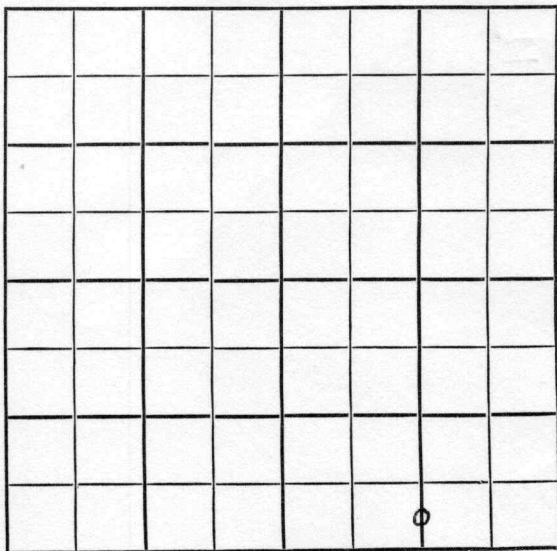

SOUTH

McPherson KANSAS

SEC.	TWP.	R.
18	21	5W

WELL NO.

1 Neufeld

FARM

COMPANY

Stag Drlg. et al

CONTRACTOR

Co. Tools

Wildcat

Ft. from N. Line

330


Ft. from S. Line

1320

990

Ft. from E. Line

Ft. from W. Line

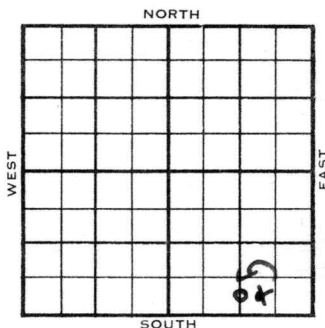

C S/2 S/2 SE
~~SW SE SE~~

1954	ELEVATION 1539'	REPORT
------	--------------------	--------

10/6

Spud 10-2-54
 8" @ 155'
 Drlg. 992'

10/20

Spud 10-2-54

D & A

TD 4034'

8" @ 155'

Heeb 2560', Br. Lime 2784', KC 2812'

Cong 3362', Miss 3440', Viola 3880'

Simp 3915', Arb 3982'

TD 4034'

D & A

ABANDONED

County

McPherson

State

Kansas

Sec.

18

(Blk.)
(Twp.)

21

(Sur.)
(Rge.)

5 W

Map No.

Operator

Stag Drlg. etal.

Well No.

1

Farm

Neufeld

Elev.

Location

SW SE SE

FIRST REPORT

330 Ft. From

S

Line

SE

990 Ft. From

E

Line

Quarter

1st. Report

OCT

6

1954

Completion

Remarks

Co. tools

Spudding Date

10-2-54

Drlg. Data

Wildcat

8" @ 155

drlg. 992

FABEN GILSTRAP

Kansas

Map No. _____ Sec. 18 Twp. 21 R. 5W

Well No. 1 Neufeld

Stag Drlg. Company _____

CORRECTION Contractor _____

C $S\frac{1}{2}$ $S\frac{1}{2}$ SE

SECTION PLAT

			4

_____ Ft. from N. Line

330 Ft. from S. Line

1320 Ft. from E. Line

_____ Ft. from W. Line

McPherson County

Location _____

Rig up _____

Drilling and Remarks:

Reported
SW SE SE

RECORD

Cased _____ in., _____ ft.

Sand _____

Gas _____

Oil _____

Total Depth _____

PRODUCTION

1st 24 hrs. Nat. _____

1st 24 hrs. after shot _____

Gas _____ Cu. Ft.

Dry Hole _____


Abandoned _____

Date

OCT 13 1954

FABEN GILSTRAP

Scout

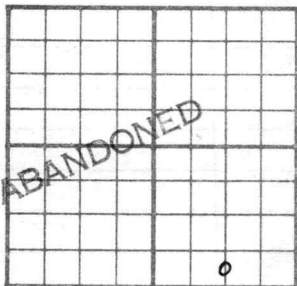County McPherson State KansasSec. 18 (Blk.
Twp.) 21 (Sur.
Rge.) 5W Map No.Operator Stag Drlg. etal.Well No. 1 Farm NeufeldElev. 1539 Location C S $\frac{1}{2}$ S $\frac{1}{2}$ SE330 Ft. From S Line SE1320 Ft. From E Line Quarter1st. ReportCompletion OCT 20 1954Remarks WildcatCo. toolsSpudding Date 10-2-54Drlg. Data D & A TD 40348" @ 155 Heeb. 2560 Br. lime 2784KC 2812 Cong. 3362 Miss. 3440Viola 3880 Simp. 3915 Arb. 3982TD 4034D & A

FABEN GILSTRAP