


KANSAS

 McPhersonSection 20 Township 21 Range 5WWell No. 1 EidgerCompany Holl & Prather

Wildcat

NORTH

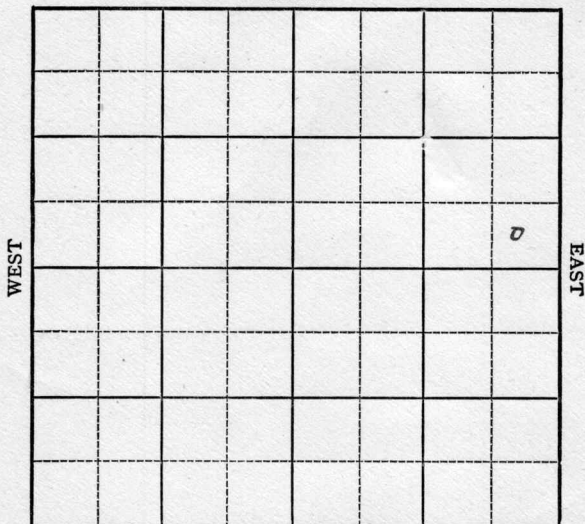

SOUTH

KANSAS

McPherson

Sec. 20 Twp. 21 R. 5W ✓

Well No. #1 Eidger Farm

Holl & Pratner Company

Wildcat (Shawver- Graham, Cont.)

 Ft. from N. Line

330'


 Ft. from S. Line

330'

 Ft. from E. Line

 Ft. from W. Line

SE NE

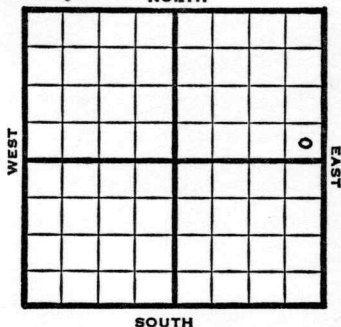

1949

Elev. 1511' REPORT

7/13

Drlg. 2800'

7/20

Lansing 2825'

KC 2910'

Miss 3398'

Viola 3906'

Drlg 3939'

7/27

Arb. 4007'

TD 4016'

ABANDONED

Map No. _____ Sec. 20 Twp. 21 R. 5W

Well No. 1 Eidger

Holl & Pratner Company

Shawver - Graham Contractor

SE NE

**FIRST REPORT
SECTION PLAT**

_____ Ft. from N. Line

330 Ft. from S. Line

330 Ft. from E. Line

_____ Ft. from W. Line

McPherson County

Location _____

Rig up _____

Drilling and Remarks:

drlg. 2800

RECORD

Cased _____ in., _____ ft.

Sand _____

Gas _____

Oil _____

Total Depth _____

PRODUCTION

1st 24 hrs. Nat. _____

1st 24 hrs. after shot _____

Gas _____ Cu. Ft.

Dry Hole _____

Abandoned _____

Date

JUL 13 1949

19

S. J. LEWIS

Scout

Kansas

Wildcat


Map No. K48 Sec. 20 Twp. 21 R. 5WWell No. 1 EidgerHoll & Prather

Company

ABANDONED

Contractor

SE NE

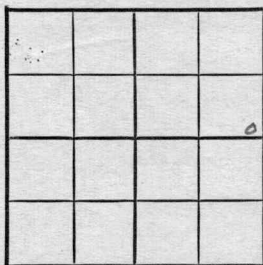E11511
SECTION PLAT Ft. from N. Line330 Ft. from S. Line330 Ft. from E. Line Ft. from W. LineMcPherson CountyLocation Rig up

Drilling and Remarks:

Cor 44007**RECORD**Cased in., ft.Sand Gas Oil Total Depth 1516**PRODUCTION**1st 24 hrs. Nat. 71st 24 hrs. after shot Gas Cu. Ft.Dry Hole Abandoned

Date

JUL 27 1949

19

S. J. LEWIS

Scout