

Rice


FORM 51

KANSAS

Section 1 Township 21 Range 6W

Well No. #1 Blew

Company Jim Chew

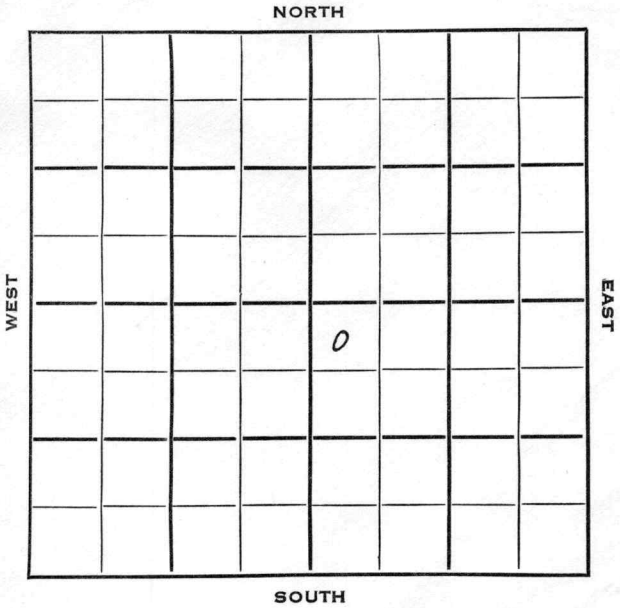

Rice

KANSAS

SEC.	TWP.	R.
1	21	6W ✓

WELL NO.

#1 Blew

FARM

COMPANY

Jim Chew

CONTRACTOR

Herndon Drlg.

E. Welch Pool NORTH

330


Ft. from N. Line

Ft. from S. Line

Ft. from E. Line

330

Ft. from W. Line

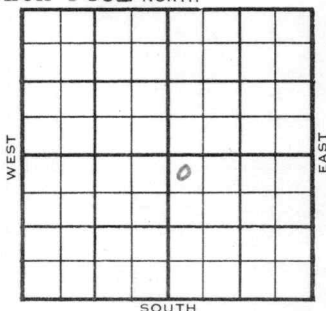

NW NW SE

	ELEVATION	REPORT
1954	1535'	

4/21

Spud 4-14-54

8" @ 137'

Drlg 2500'

5/5

Miss 3337'

5/12

NR

5/19

Spud 4-14-54

Oil Well

tD 3368'

8" @ 137'

Miss 3337',


TD 3350'

5" @ 3349'

DD 3368'

Comp 10 bopd & wtr.

COMPLETED

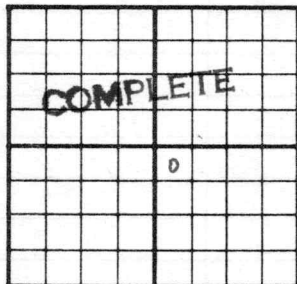County Rice State KansasSec. 1 (Blk.) 21 (Sur.) 6W Map No.Operator Jim ChewWell No. 1 Farm BlewElev. 1535 Location NW NW SE330 Ft. From N Line SE330 Ft. From W Line Quarter1st. Report MAY 1 9 1954Completion Remarks E. Welch PoolHerndon Drlg. - Contr.Spudding Date 4-14-54Drlg. Data Oil well TD 33688" @ 137 Miss. 3337 TD 3350 5" @ 3349DD 3368 Comp. 10 bopd & wtr.