

KANSAS


FORM 51 5M PETROL

Barton

Section 34 Township 20 Range 14W

Well No. #1 L. Pritchard

Company Texas

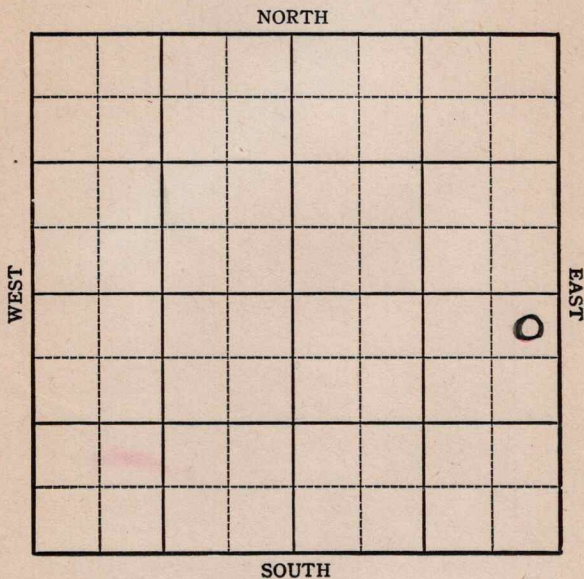

Barton

Sec. 34 Twp. 20 R. 14W

Well No. #1 L. Pritchard Farm

Texas Company

Wildcat


330 Ft. from N. Line

 Ft. from S. Line

330 Ft. from E. Line

 Ft. from W. Line

Geo. 1914

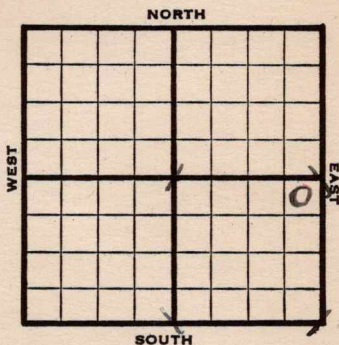

1944

REPORT

4/5	Location
4/12	13" @ 183 Drlg. 400
4/19	Drlg. 2152
4/26	Lans 3275 Coring 3280
5/3	SO 3285-91 Arb 3544-48 TD Sat Run csg.
5/10	Arb 3541 corrected 5" @ 3542 TD 3545 swb 202 oil in 9 hrs.
5/17	" "
5/31	Arb 3541 5" @ 3542 TD 3545 1000 acid Echo Pot 1526 Grav. 36

COMPLETED

KANSAS
Map No. 82 Sec. 34 Twp. 20 R. 14WWell No. 1 L. PritchardTexas

Company

FIRST REPORT

Contractor

NE SE


SECTION PLAT

330 Ft. from N. Line

Ft. from S. Line

330 Ft. from E. Line

Ft. from W. Line

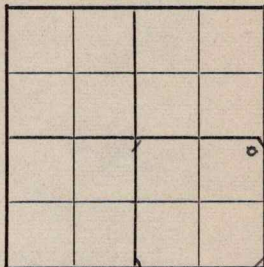

Wild cat

Location X

Rig up

Drilling and Remarks:

RECORD

Cased _____ in., _____ ft.

Sand _____

Gas _____

Oil _____

Total Depth _____

PRODUCTION

1st 24 hrs. Nat. _____

1st 24 hrs. after shot _____

Gas _____ Cu. Ft.

Dry Hole _____

Abandoned _____

Date

APR 5 1944 19

S. J. LEWIS Scout

Pool Name Wildcat

KANSAS
 Map No. 82 Sec. 34 Twp. 20 R. 14 W

Well No. 1 L. PritchardTexas

Company _____

COMPLETED

Contractor _____

NE SE

SECTION PLAT

			o

330 Ft. from N. Line

Ft. from S. Line _____

330 Ft. from E. Line

Ft. from W. Line _____

Barton County

Location _____

Rig up _____

Drilling and Remarks:

Cor 73541
5" @ 3542
1000 Acid
Echd 1526

36° 9'

RECORD

Cased _____ in., _____ ft.

Sand _____

Gas _____

Oil _____

Total Depth 3545

PRODUCTION

1st 24 hrs. Nat. _____

1st 24 hrs. after shot _____

Gas _____ Cu. Ft.

Dry Hole _____

Abandoned _____

Date

MAY 31 1944 19S. J. LEWIS Scout