

DX 78-1


Rice

KANSAS

Section 1 Township 21 Range 6W

Well No. 2 Lackey "C"

Company Stag Drlg.

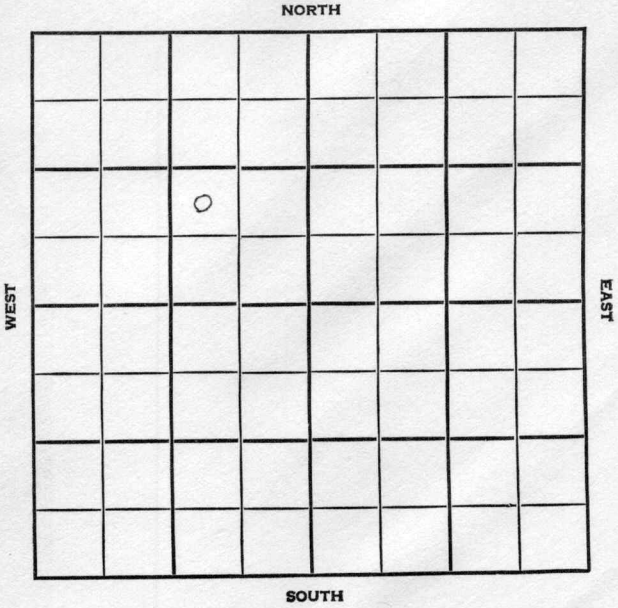

Rice

KANSAS

SEC.

TWP.

R.

1

21

6 W

WELL NO.

2 Lackey "C"

FARM

COMPANY

Stag Drlg.

CONTRACTOR

Co. tools

Welch-Bornholdt Pool

NORTH

Ft. from N. Line

990


Ft. from S. Line

990

Ft. from E. Line

Ft. from W. Line

NW SE NW

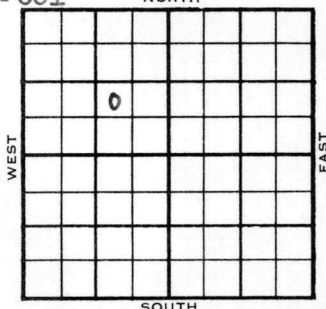

ELEVATION

REPORT

1955

1535'

4/27

Spud 4-23-55

8" @ 144

Drlg. 1791'

5/25

~~Spud~~ Br. Ls 2705'; Lsg 2726; Congl

3305; Miss 3341; TD 3362; 8"

144; no log; 5½ 3348; swb 8 goph

plus 12% wtr. 4 hrs; frac; swb

9½ BO plus 18% wtr 6 hrs; pmp

25 bopd 20% wtr from Miss 3348-62

COMPLETED

County Rice State Kansas

Sec. 1 (Blk. Twp.) 21 (Sur. Rge.) 6W Map No.

Operator Stag Drlg.

Well No. 2 Farm Lackey "C"

Elev.	Location	NW	SE	NW
-------	----------	----	----	----

0

FIRST REPORT

990 Ft. From S Line NW

990 Ft. From E Line Quarter

1st. Report APR 27 1955

Completion

Remarks

Co. tools

Spudding Date 4-23-55

Drlg. Data Welch-Bornholdt Pool

8" @ 144 drlg. 1791

FABEN GILSTRAP