

KANSAS


Rice

FORM 51 5M PETROL

Section 2 Township 21 Range 6W

Well No. 1 Duvall

Company H. C. Bennett etal

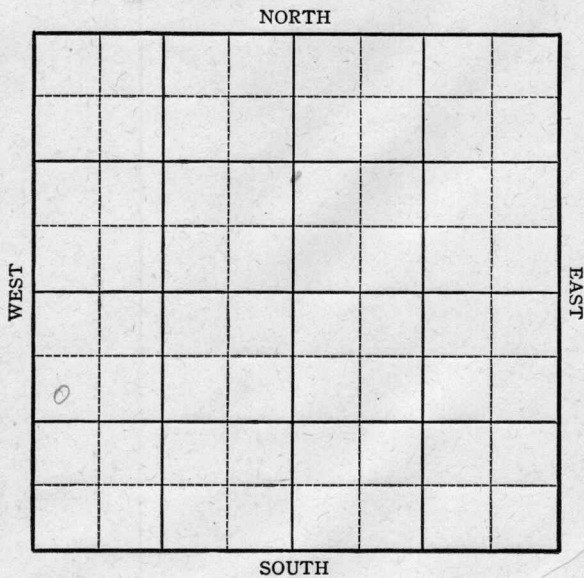

KANSAS Rice

Sec. 2 Twp. 21 R. 6-W

Well No. #1 Duvall Farm


H. C. Bennett et al Company

990 Ft. from N. Line

Ft. from S. Line

Ft. from E. Line

330 Ft. from W. Line

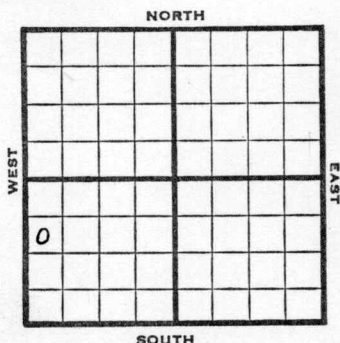

SW NW SW@

1945 Elev. 1561

REPORT

9/26 RUR

10/3 10" @ 142
Drlg. 2485'

10/10 Drlg. 3300'

10/17 Miss. 3364

TD 3368

7" @ 3364 RUST

10/24 " " "

10/31 TD 3398

2900' oil

11/7 " "

11/14 " "

11/21 " "

11/28 Miss. 3364

7" @ 3364

TD 3398

Pump 150 Pot.

Grav. 34.0

COMPLETED

KANSAS


Pool Name WelchMap No. 48 Sec. 2 Twp. 21 R. 6WWell No. 1 DuvallH. C. Bennett etal Company

FIRST REPORT

Contractor

SW NW SW

SECTION PLAT

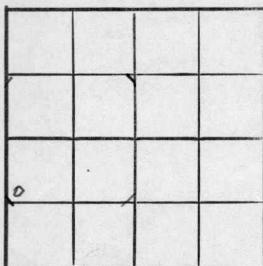990 Ft. from N. Line Ft. from S. Line Ft. from E. Line330 Ft. from W. Line

Rice County

Location Rig up

Drilling and Remarks:

RUR

RECORD

Cased in., ft.Sand Gas Oil Total Depth

PRODUCTION

1st 24 hrs. Nat. 1st 24 hrs. after shot Gas Cu. Ft.Dry Hole Abandoned

Date

SEP 26 1945

19

J. J. LEWIS

Scout

KANSAS Kansas Pool Name WelchMap No. 48 Sec. 2 Twp. 21 R. 6WWell No. 1 DuvallH. C. Bennett etal Company**COMPLETED**

Contractor

E. A. 561

SW NW SW

SECTION PLAT


990 Ft. from N. Line

Ft. from S. Line

Ft. from E. Line

330 Ft. from W. Line

Rice County

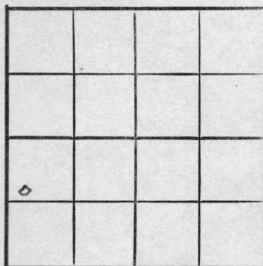

Location

Rig up

Drilling and Remarks:

Miss 88647" C 8864Pump 150 BX34° G**RECORD**

Cased _____ in., _____ ft.

Sand _____

Gas _____

Oil _____

Total Depth 3398**PRODUCTION**

1st 24 hrs. Nat. _____

1st 24 hrs. after shot _____

Gas _____ Cu. Ft.

Dry Hole _____

Abandoned _____

Date

NOV 28 1945 19

S. J. LEWIS

Scout