

Rice


FORM 51 5M PETROL

KANSAS

Section 2 Township 21 Range 6W

Well No. #3 Duvall

Company H.C. Bennett et al

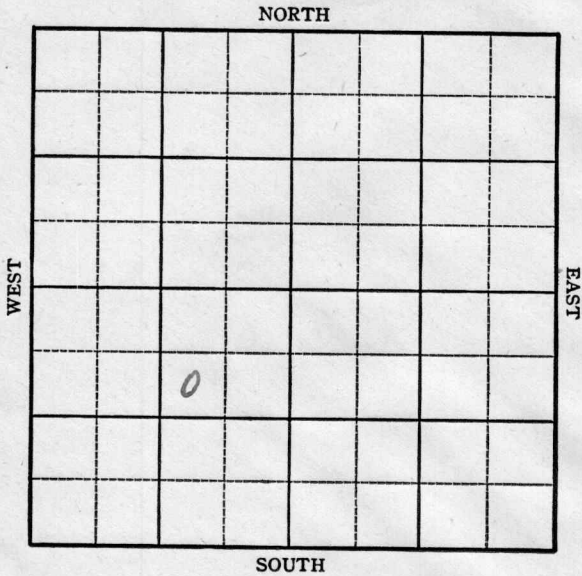

Sec. 2 Twp. 21 R. 6-W

Well No. #3 Duvall Farm

H. C. Bennett et al Company


990 Ft. from N. Line

 Ft. from S. Line

990 Ft. from E. Line

 Ft. from W. Line

SW NE SW

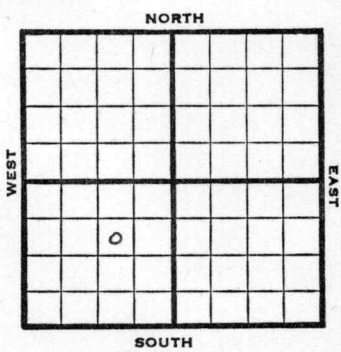

1945	Elev. 1550'	REPORT
12/5	Location	
12/12	10" @ 140 Drlg. 1538	
12/20	Drlg. 2680'	
12/29	" "	
1946		
1/10	Miss. 3369' T.D. 3376' 7" - 3373' RUST.	
1/17	Drlg. 3386' S. Gas	
1/24	T.D. 3403' 1200' oil & 200' water 12 hr	
1/30	Miss. 3369 7" @ 3373 TD 3403 Pump 40 oil plus 10 Wtr. Pot. Grav. 34.0	

COMPLETED

KANSAS

Kansas Pool Name WelchMap No. 78 Sec. 2 Twp. 21 R. 6WWell No. 3 DuvallH. C. Bennett etal CompanyFIRST REPORT Contractor

SW NE SW

SECTION PLAT

990 Ft. from N. Line Ft. from S. Line990 Ft. from E. Line Ft. from W. LineRice CountyLocation XRig up

Drilling and Remarks:

RECORD

Cased in., ft.Sand Gas Oil Total Depth

PRODUCTION

1st 24 hrs. Nat. 1st 24 hrs. after shot Gas Cu. Ft.Dry Hole Abandoned

Date

DEC 5 1945 19 S. J. LEWIS Scout

KANSAS

Kansas Pool Name WelchMap No. 48 Sec. 2 Twp. 21 R. 6WWell No. 3 DuvallH.C. Bennett etal Company


COMPLETED

Contractor

E. 1508

SW NE SW

SECTION PLAT

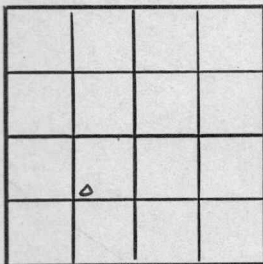990 Ft. from N. Line Ft. from S. Line990 Ft. from E. Line Ft. from W. Line

Rice County

RECORD

Location Cased in., ft.Rig up Sand

Drilling and Remarks:

Gas Oil Total Depth 3403

PRODUCTION

1st 24 hrs. Nat. 1st 24 hrs. after shot Gas Cu. Ft.Dry Hole Abandoned

Date

JAN 30 1946 19

S. J. LEWIS

Scout