

KANSAS

Barton

Section 34 Township 20 Range 14W

Well No. #3 Taylor "B"


Company Cities Service

Brichard Pool

NORTH

WEST

EAST

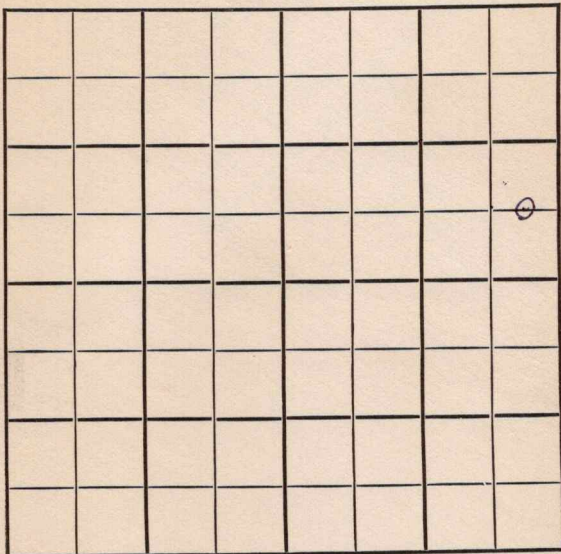

SOUTH

Sec. 34 Twp. 20 R. 14W

Well No. #3 Taylor "B" Farm

Cities Service

Company


Prichard

 Ft. from N. Line

660 Ft. from S. Line

330 Ft. from E. Line

 Ft. from W. Line

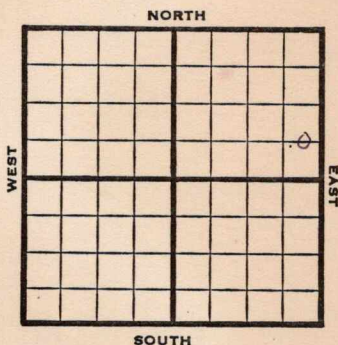

C E L S E N E

1948

Elev. 1910' REPORT

4/7 Drlg. 170'

4/14 Drlg. 2620'

4/21 Arbuckle 3535'

TD 3538'

5" @ 3536'

RUST

4/28 SLM 3538=35

Arbuckle 3532'

5" @ 3532'

TD 3535'

Pump 109 bbls. oil in 12 hrs.

5/5 Arbuckle 3532'

5" @ 3532'

Echo Pot. 1190 oil & 227 W

Gr. 38°

TD 3535'

COMPLETED

Map No. _____ Sec. 34 Twp. 20 R. 14W

Well No. 3 Taylor "B"

Cities Service


Company

FIRST REPORT

Contractor

C E L SE NE

SECTION PLAT

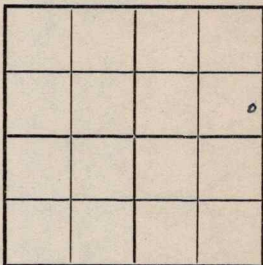

_____ Ft. from N. Line

660 Ft. from S. Line

330 Ft. from E. Line

_____ Ft. from W. Line

Barton County

Location _____

Rig up _____

Drilling and Remarks:

drlg. 170

RECORD

Cased _____ in., _____ ft.

Sand _____

Gas _____

Oil _____

Total Depth _____

PRODUCTION

1st 24 hrs. Nat. _____

1st 24 hrs. after shot _____

Gas _____ Cu. Ft.

Dry Hole _____

Abandoned _____

Date

APR 7 1948

19

S. J. LEWIS

Scout

Map No. 82 Sec. 34 Twp. 20 R. 14W

Well No. 3 Taylor "B"

Cities Service Company

COMPLETE

Contractor

C E L S E N E

E1910
SECTION PLAT

 Ft. from N. Line

660 Ft. from S. Line

330 Ft. from E. Line

 Ft. from W. Line

			a

Barton County

Location

Rig up

Drilling and Remarks:

Car 8332

5-123032

Ec 1190m

7227W

8834

RECORD

Cased in., ft.

Sand

Gas

Oil

Total Depth

PRODUCTION

1st 24 hrs. Nat.

1st 24 hrs. after shot

Gas Cu. Ft.

Dry Hole

Abandoned

Date

MAY 5 1948 19 S. J. LEWIS Scout