

Rice

FORM 51

KANSAS

Section 1 Township 21 Range 6W

Well No. #2 Lackey

Company Stag Drlg. et al

NORTH

WEST

EAST

	0						

SOUTH

Rice KANSAS

SEC.	TWP.	R.
1	21	6W ✓

WELL NO.

2 Lackey

FARM

COMPANY

Stag Drlg. et ala

CONTRACTOR

Stag Drlg.


E. Welch Pool

330 Ft. from N. Line

Ft. from S. Line

Ft. from E. Line

990 Ft. from W. Line

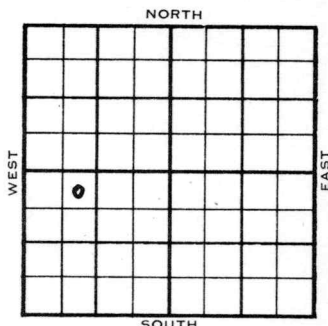

NE NW SW

	ELEVATION	REPORT
1954	1551'	

3/17 Spud 3-14-54

3/24 8" @ 140' w/125 sks
 KC 2784'
 Drlg. 3074'

3/31 Cong 3356', Miss 3370'
 RTD 3375'
 5" @ 3373'
 DD 3389½

4/7 FU 400' fluid 50% Wtr. sd-frac.
 S/1 bo + 11 bwph
 DD 3395'
 TD HFW
 PB 3389

5/12 Spud 3-14-54
 Oil Well
 TD 3395'
 8" @ 140'
 KC 2784', Cong 3356', Miss 3370'
 TD 3375'
 5" @ 3373'
 DD 3389'
 FU 400' fluid 50% wtr.
 Sd-frac
 S/1 bo 11 bwph
 DD 3395' HFW PB 3389

OVER

1954
5/12

(Information Brought Forward)


P/15 bo 75% wtr. 24 hrs.

Comp. 2 bopd 75% wtr.

COMPLETED

J. G. McGEHEE

County Rice State Kansas
 Sec. 1 (Blk.) 21 (Sur.) 6W Map No.
 Operator Stag Drlg. etal.
 Well No. 2 Farm Lackey
 Elev. 1551 Location NE NW SW

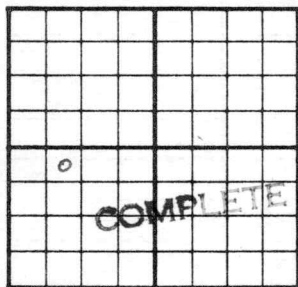

330 Ft. From N Line SW
990 Ft. From W Line Quarter

1st. Report

Completion MAY 12 1954

Remarks E. Welch Pool
Stag Drlg. - Contr.

Spudding Date 3-14-54

Drlg. Data Oil well TD 3395

8" @ 140 KC 2784 Cong. 3356

Miss. 3370 TD 3375 5" @ 3373

DD 3389 FU 400' fluid 50% wtr.

sd-frac S/ 1 bo 11 bwph DD 3395

HFW PB 3389 P/ 15 bo 75% wtr. 24 hr.

Comp. 2 bopd 75% wtr.

J. G. McGEHEE