

Section 1 Township 21 Range 6W

Well No. #1 Lackney "C"

Company Stag Drlg et al.

NORTH

		0					

WEST

EAST

SOUTH

Rice KANSAS

SEC. 1 TWP. 21 R. 6W

WELL NO. 1 Lackey "C" FARM

COMPANY Stag Drlg. et al


CONTRACTOR Co. Tools
Welch-Bornholdt Pool

330 Ft. from N. Line

Ft. from S. Line

990 Ft. from E. Line

Ft. from W. Line

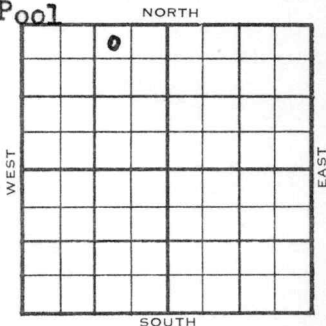

NW NE NW

	ELEVATION	REPORT
1955	1533'	

4/6

Spud 4-3-55
8" @ 141'
Drlg. 758'

4/27

Spud 4-3-55 - Oil Well
TD 3344'
8" @ 141'
Br. Lime 2722', Lans. 2743', Cong. 3317', Miss. 3332'
TD 3342'
5" @ 3339'
DD 3344'
S/2 boph frac
S/10 boph 6 hrs.
Comp. 25 bopd

COMPLETED

County Rice State Kansas

Sec. 1 (Blk. 21) (Sur. 6W) Map No.

Operator Stag Drlg. etal.

Well No. 1 Farm Lackey "C"

Elev. Location NW NE NW

	0				

330 Ft. From N Line NW

990 Ft. From E Line Quarter

Ist. Report APR 6 1955

Completion

Remarks

Co. tools

Spudding Date 4-3-55

Drlg. Data Welch-Bornholdt Pool

8" @ 141 drlg. 758

FABEN GILSTRAP

County Rice State Kansas

Sec. 1 (Blk. (Twp.)) 21 (Sur. Rge.) 6W Map No.

Operator Stag Drlg. etal.

Well No. 1 Farm Lackey "C"

Elev. 1533 Location NW NE NW

		0			

330 Ft. From N Line NW

990 Ft. From E Line Quarter

1st. Report

Completion APR 27 1955

Remarks Welch-Bornholt Pool

Co. tools

Spudding Date 4-3-55

Drlg. Data Oil well TD 3344

8" @ 141 Br. lime 2722 Lans. 2743

Cong. 3317 Miss. 3332 TD 3342

5" @ 3339 DD 3344 S/ 2 boph frac

S/ 10 boph 6 hr. Comp. 25 bopd

[Handwritten signature]