


Section 35 Township 20 Range 14W

Well No. 2 Roscoe "A"

Company Phillips Petr.

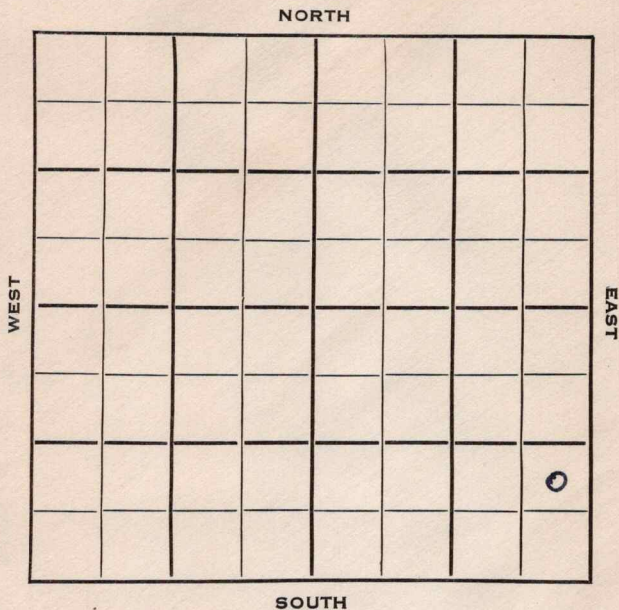


SEC.	TWP.	R.
35	20	14 W

WELL NO. # 2 Roscoe "A" FARM

COMPANY Bhillips Pet.

CONTRACTOR Phillips Pet.
SE Pritchard Pool

_____ Ft. from N. Line
 990 _____ Ft. from S. Line
 330 _____ Ft. from E. Line
 _____ Ft. from W. Line

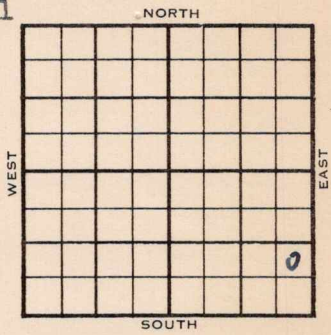

NE SE SE

	ELEVATION	REPORT
1953	1908'	
10/28		Location
11/4		10" @ 604 Drlg. 1978'
11/11		Top 2844', Heeb 3127', Tor 3146', Br li 3238', Lans 3248', B KC 3457', Arb. 3480' TD 3484' Schl 7" @ 3479'
11/18		CO 3484', trace O&W DD 3504 1/2, 100' oil, 1/2 hrs. S/14 1/2 BO S/13 1/2 BO 3 hrs. DD 3509 TD S/59-3/4 BO 10 hrs.
12/9		P/234 BOPD
12/16		Spud 10-30-53 Oil Well TD 3509' 10" @ 604' Top 2844', Heeb 3127', Tor 3146', Br. Lime 3238', Lans 3248', B KC 3457', Arb. 3480' TD 3484' 7" @ 3479' CO to 3484, DD 3504', 100' oil 1/2 hrs.

OVER

750585

(Information Brought Forward)

1953

12/16

S/14 $\frac{1}{2}$ bo

S/13 $\frac{1}{2}$ bo 3 hrs.

DD 3509'

S/59-3/4 bo 10 hrs.

Comp. 229 bopd

COMPLETED

