
FORM 51 25M 8-50 WESTERN Barton KANSAS

Section 35 Township 20 Range 14W

Well No. #1 Weathers

Company Hinkle Oil

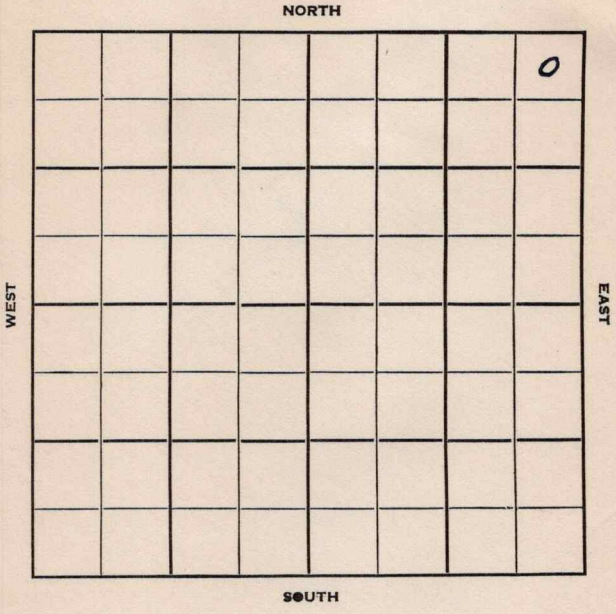

FORM 252-B
10M 10-50 PETROL

Barton KANSAS

Sec. 35 Twp. 20 R. 14W

Well No. #1 Weathers Farm

Hinkle Oil Company

Hinkel - Contr. Contractor


330' Ft. from N. Line

Ft. from S. Line

330' Ft. from E. Line

Ft. from W. Line

NE NE NE

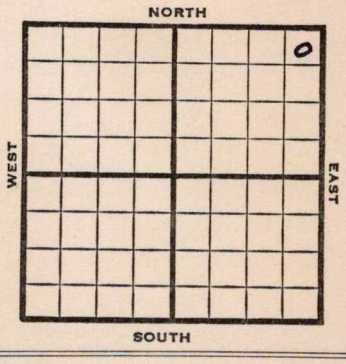

1952	Elev. 1905' REPORT
7/16	Spud 7-10-52 " @ 510 Anhy 795 Drlg. 2032
7/23	Heeb. 3154 Lans. 3275 DST 3308-15, 35 mins. 115' m 450# DST 3423-37, 1/2 hr. 25' O&GCM 150' oil 150' HOCM 1108# Arb. 3528' RTD 3590'
7/30	5" @ 3590' 24/ 3543-47 4 Boph tub & rods
8/6	NR
8/13	"
8/20	"
8/27	Spud 7-10-52 Oil Well TD 3590 8" @ 510 Anhy 795 Heeb. 3154 Lans. 3275 DST 3308-15 open 35 min. rec. 115' mud 450# DST 3423-37 open ½ hr. rec. 25' O&GCM 150' oil 150' HOCM 1108# Arb. 3528 TD 3590 ✗ 5" @ 3590 24/ 3543-47 4 boph Comp. 139 bopd 2% wtr. COMPLETED

FORM 275 FOR SALE BY KANSAS BLUE PRINT CO.


County Barton State Kansas

Sec. 35 (Blk. Twp.) 20 (Sur. Rge.) 14W Map No.

Operator Hinkle Oil

Well No. 1 Farm Weathers

Elev. Location NE NE NE

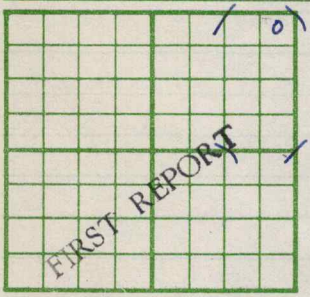

330 Ft. From N Line NE

330 Ft. From E Line Quarter

1st. Report JUL 1 6 1952

Completion

Remarks

Hinkel - Contr.

Spudding Date 7-10-52

Drlg. Data

"@ 510 Anhy 795 Drlg. 2032

J. G. McGEHEE

FORM 275 FOR SALE BY KANSAS BLUE PRINT CO.


County Barton State Kansas

Sec. 35 (Blk. Twp.) 20 (Sur. Rge.) 14W Map No.

Operator Hinkle Oil

Well No. 1 Farm Weathers

Elev. 1905 Location NE NE NE

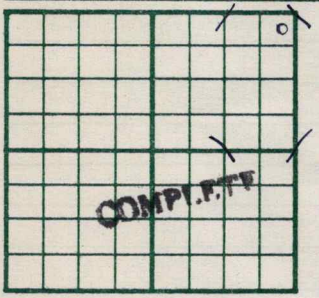

330 Ft. From N Line NE

330 Ft. From E Line Quarter

1st. Report

Completion AUG 27 1952

Remarks

Hinkle - Contr.

Spudding Date 7-10-52

Drlg. Data Oil well TD 3590

8" @ 510 Anhy 795 Heeb. 3154

Lans. 3275 DST 3308-15 open 35 min.

Rec. 115' mud 450# DST 3423-37

open ½ hr. Rec. 25' o & gcm 150' oil

150' hocm 1108# Arb. 3528 TD 3590

5" @ 3590 24/ 3543-47 4 boph

Comp. 139 bopd 2% water

J. G. McGEHEE