

KANSAS

FORM 51 5M 1-42 PETROL


Rice

Section 17 Township 19 Range 9-W

Well No. #2 Link

Company Lario Oil & Gas

Chase pool

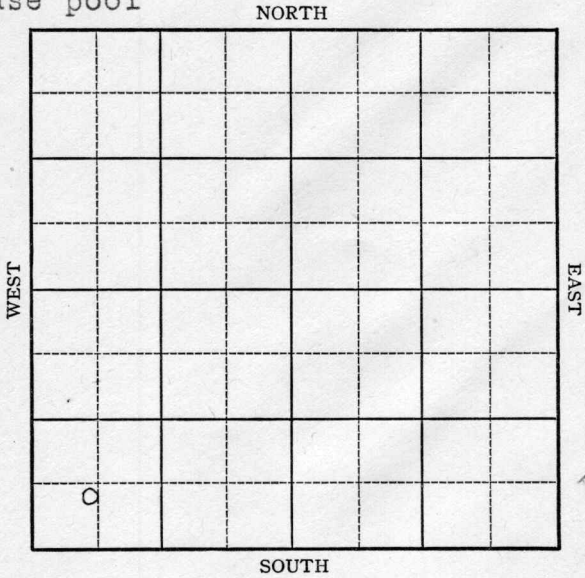

KANSAS


Rice

Sec. 17 Twp. 19 R. 9-W

Well No. #2 Link Farm

Lario Oil & Gas Company

Chase Pool

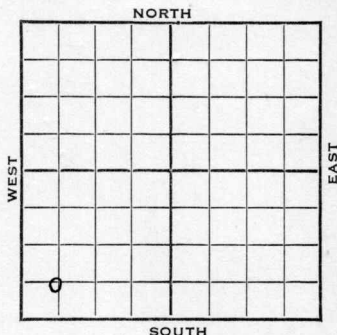

 Ft. from N. Line

554 Ft. from S. Line

 Ft. from E. Line

554 Ft. from W. Line

C SW SW Elev. 1728

1942

REPORT

11/24	Loc
12/2	Spud
12/9	10" @ 250 Drlg. 1648
12/16	Lans 2908 Drlg. 3057
12/22	BKC 3200 Congl. 3233 Arb. 3245 TD 3253 Swab. 5" @ 3245' RUST
12/29	" "
1943	
1/6	T. D. 3263-250 250 gals acid swab 15 oil per hr
1/13	Temp pot pump 72 bbls oil & 15 gals water.
1/20	" " " " " "
1/27	" " " " " "
2/3	" " " " " "
2/10	" " " " " "
2/17	" " " " " "

OVER

1943

2/24 Temp pot pump 72 oil & 15 wtr.

3/3

Arb. 3245

5" @ 3245'

T.D. 3262'

250 gal acid.

Pump 25 Pot.

Gravity 42.4

COMPLETED

KANSAS

Rice

Map No. 49 Sec. 17 Twp. 19 R. 9WWell No. 2 Link

Lario Oil & Gas

Company

FIRST REPORT

Contractor

C SW SW

SECTION PLAT

6			

 Ft. from N. Line554 Ft. from S. Line Ft. from E. Line554 Ft. from W. Line

CHASE POOL

Location XXXRig up

Drilling and Remarks:

RECORD

Cased in., ft.Sand Gas Oil Total Depth

PRODUCTION

1st 24 hrs. Nat. 1st 24 hrs. after shot Gas Cu. Ft.Dry Hole Abandoned

Date

NOV 24 1942 19S. J. LEWIS Scout

Map No. KANSAS Sec. 17 Twp. 19 R. 9WWell No. 2 LinkLario Oil & Gas CompanyCOMPLETED Contractor

C SW SW

 Ft. from N. Line554 Ft. from S. Line Ft. from E. Line554 Ft. from W. Line

SECTION PLAT

0			

CHASE POOL

Location Rig up

Drilling and Remarks:

Ce & 3245
5" @ 3245
250 acid
Pump 25 P.D.

42 1/2 hr

RECORD

Cased in., ft.Sand Gas Oil Total Depth 3262

PRODUCTION

1st 24 hrs. Nat. 1st 24 hrs. after shot Gas Cu. Ft.Dry Hole Abandoned

Date

MAR 3 1943 19 S. J. LEWIS Scout