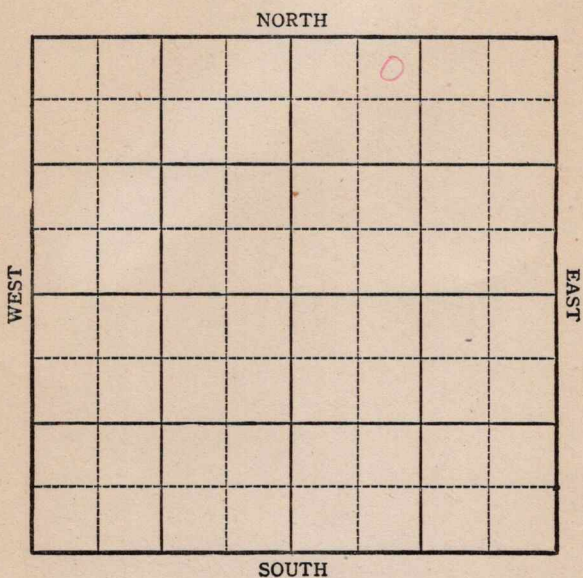


KANSAS

Barton County

Section 36 Township 20 Range 14WWell No. #1 SpaniCompany Phillips

KANSAS

Barton County


Sec. 36 Twp. 20 R. 14W

Well No. #1 Spani Farm

Phillips Company

Pritchard

NORTH

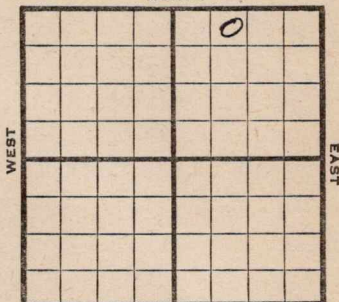

330 Ft. from N. Line

Ft. from S. Line

Ft. from E. Line

990 Ft. from W. Line

NE NW NE Elev. 1900

SOUTH

1944

R E P O R T

11/1	Location
11/8	"
11/16	"
11/24	Drlg. 265
11/29	10" @ 600 Drlg. 2250
12/6	Land 3189 3200 fsg.
12/14	7" @ 3254'-3263 TD 3263 RUST
12/21	" " " "
12/29	TD 3263' 2750' fluid
1945	
1/3	7 M gas Flow 21 oil in 6 hrs
1/10	" " " " " " "
1/17	PB
1/26	"
1/31	Drlg. 3267 1766' oil in 17 hrs.
2/7	TD 3277 - 1500 acid flow 328 oil in 5 hrs 125,000 gas
2/14	" " " " "
2/21	" " " " "

OVER

750.645

1945


2/28 **Lans** **3189**
7" @ 3259
1500 acid
TD 3277
Bomb Pot. 4470
Max. 3000
Grav. 38.7

COMPLETED

Pool Name PritchardMap No. 82 Sec. 36 Twp. 20 R. 14WWell No. 1 SpaniPhillips CompanyFIRST REPORT Contractor

NE NW NE

SECTION PLAT

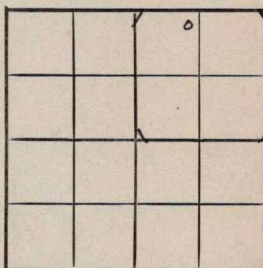330 Ft. from N. Line Ft. from S. Line Ft. from E. Line990 Ft. from W. LineBartonLocation XRig up

Drilling and Remarks:

RECORD

Cased in., ft.Sand Gas Oil Total Depth

PRODUCTION

1st 24 hrs. Nat. 1st 24 hrs. after shot Gas Cu. Ft.Dry Hole Abandoned

Date

NOV 1 1944 19S. J. LEWIS Scout

Pool Name PritchardMap No. 82 Sec. 36 Twp. 20 R. 14WWell No. 1 SpaniPhillips CompanyCOMPLETED

Contractor

NE NW NE

SECTION PLAT

		o	

330 Ft. from N. Line

Ft. from S. Line

Ft. from E. Line

990 Ft. from W. LineBarton

Location

Rig up

Drilling and Remarks:

*Lans 3189**7" @ 3259**1500 acid**Ben YH 44470**May 3000**2538*

RECORD

Cased _____ in., _____ ft.

Sand _____

Gas _____

Oil _____

Total Depth 3272

PRODUCTION

1st 24 hrs. Nat. _____

1st 24 hrs. after shot _____

Gas _____ Cu. Ft.

Dry Hole _____

Abandoned _____

Date

FEB 28 1945 19S. J. LEWIS Scout