


KANSAS Barton

FORM 51 5M PETROL

Section 36 Township 20 Range 14W

Well No. 1 Weathers

Company Phillips

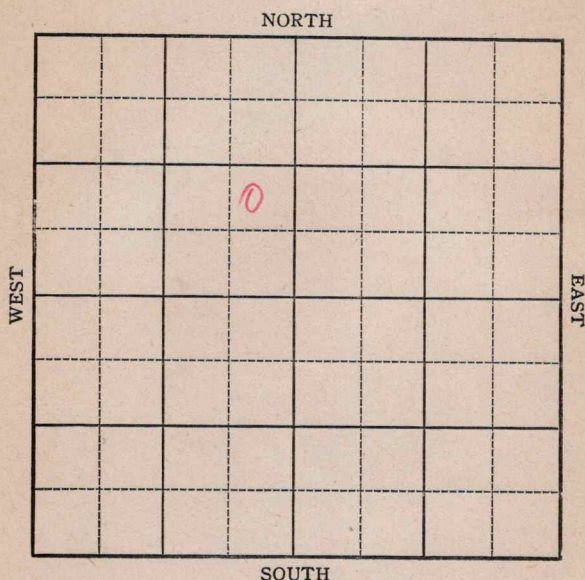

KANSAS

Barton County

Sec. 36 Twp. 20 R. 14W

Well No. 1 Weathers Farm

Phillips Company

Prtichard


Ft. from N. Line

990 Ft. from S. Line

330 Ft. from E. Line

Ft. from W. Line

NE SE NW Elev. 1905

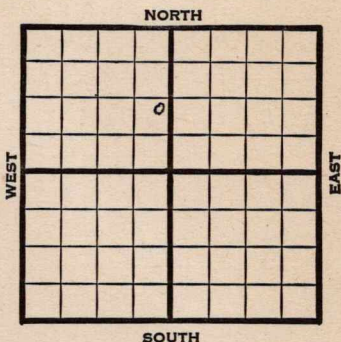

REPORT

1945

5/2

Location

5/10

"

5/17

8" @ 609

Drlg. 2085

5/24

Heebner

3097

Drlg. 3207

5/31

Lans

3218

BEC

3434

Cong

3463

Granite

3473

TD 3478

5" @ 3467' RUST

6/8

Lans 3215 Cong 3456 Granite 3466

TD 3471 Corrected 5" @ 3460

RUST

6/14

38 shots to 3444-49

6/21

500 acid flow 108 oil in 18 hrs.

1500 acid Flow 357 oil in 5 hrs

6/28

"

"

"

"

7/3

"

"

"

"

7/11

"

"

"

"

7/19

Flow 528 oil in 15 hrs.

7/25

Lans 3215

Cong 3456

Granite 3466

5" @ 3460

TD 3471

Perf. Lans 2000 acid.

Flow 1136 Pot.

Grav. 36.0

COMPLETED


Kansas Pool Name PritchardMap No. 82 Sec. 36 Twp. 20 R. 14WWell No. 1 WeathersPhillips Company

FIRST REPORT

Contractor

NE SE NW

SECTION PLAT

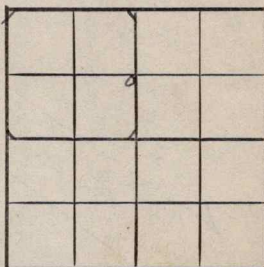 Ft. from N. Line990 Ft. from S. Line330 Ft. from E. Line Ft. from W. LineBarton CountyLocation XRig up

Drilling and Remarks:

RECORD

Cased in., ft.Sand Gas Oil Total Depth

PRODUCTION

1st 24 hrs. Nat. 1st 24 hrs. after shot Gas Cu. Ft.Dry Hole Abandoned

Date

MAY 2 1945 19 S. J. LEWIS Scout

KANSAS

Kansas Pool Name PritchardMap No. 82 Sec. 36 Twp. 20 R. 14WWell No. 1 WeathersPhillips Company

COMPLETED

Contractor

NE SE NW

E. 1905

SECTION PLAT

	0		

 Ft. from N. Line990 Ft. from S. Line330 Ft. from E. Line Ft. from W. Line

Barton County

Location Rig up

Drilling and Remarks:

Lane 3215.Cong 3456Granite 34665' @ 3460Ref Lane.2000 acidFlow 1136 RT

RECORD

Cased in., ft.Sand Gas Oil Total Depth 3471

PRODUCTION

1st 24 hrs. Nat. 1st 24 hrs. after shot Gas Cu. Ft.Dry Hole Abandoned

Date

36° SWJUL 25 1945 19S. J. LEWIS Scout