




Map No. **KANSAS** Sec. 16 Twp. 19 R. 9w

Well No. 1- Sherman Farm  
National Refg Company  
NORTH

         Ft. from N. Line

330 Ft. from S. Line

330 Ft. from E. Line

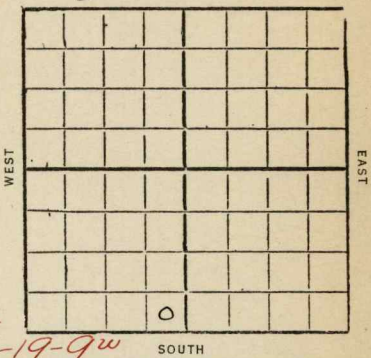

Ft. from W. Line

1932 *Our lease -*  
SW 1/4 sec. 17-19-9w

Date	REPORT
5/18	Loc
5/25	—
6/1	—
6/8	—
6/15	—
6/22	—
6/29	Cos
7/6	Run up
7/13	Spd y 100'
7/20	15" - 6/10
7/27	dreg 870'
8/3	12" - 1185
8/10	Dry 1720'
	1 <sup>st</sup> gas 2002-06
	110" - 2020
	4 barrels water 2180
	dry 2380'
8/17	show oil 2920-30
	UIR 8" csq
8/24	1 1/2 M gas 2955-60'
	TD 3024 UIR 8"

8/30- Top Conglomerate 3190'-Drilling 3214 with 2000 ft. oil in hole  
(Telegram)

8/31- TD 3226  
2600' oil in hole  
Well test

9/7- TD 3226  
pump 290 bbl 17 hr  
" 213 " 18 "

9/14- TD 3226  
pump 185 bbl 24 hr

9/21- Deepened to  
TD 3230  
Ang tubing

9/30- Sand 3190-3230  
TD 3230  
Pump 162 bbl 24 hr  
Comp.

*Rice*

*49* KANSAS

Map No. \_\_\_\_\_ Sec. *16* Twp. *19* R. *9* <sup>W</sup>

Well No. *1* *Sherman*

*National Refg Co* Company

Contractor

FIRST REPORTS

SECTION PLAT

\_\_\_\_\_ Ft. from N. Line

*330* Ft. from S. Line

*330* Ft. from E. Line

\_\_\_\_\_ Ft. from W. Line


*Our lease*  
*SW 4 17.*

Location \_\_\_\_\_ ✓

Rig up \_\_\_\_\_

Drilling and Remarks:

RECORD

Cased \_\_\_\_\_ in., \_\_\_\_\_ ft.

Sand \_\_\_\_\_

Gas \_\_\_\_\_

Oil \_\_\_\_\_

Total Depth \_\_\_\_\_

PRODUCTION

1st 24 hrs. Nat. \_\_\_\_\_

1st 24 hrs. after shot \_\_\_\_\_

Gas \_\_\_\_\_ Cu. Ft.

Dry Hole \_\_\_\_\_

Abandoned \_\_\_\_\_

Date

MAY 1 8 1932

192

CHAS. L. SHERWOOD

Scout

Rice

49 KANSAS Map No. Sec. 16 Twp. 19 R. 9 W

Well No. 1 Sherman

National Regg Co Company

Contractor

COMPLETED

SECTION PLAT

Ft. from N. Line

330 Ft. from S. Line

330 Ft. from E. Line

Ft. from W. Line


Location

Rig up

Drilling and Remarks:

Pump 16 hr  
Bld 24 Hours

RECORD

Cased in., ft.

Sand 3190-3230

Gas

Oil

Total Depth 3230

PRODUCTION

1st 24 hrs. Nat.

1st 24 hrs. after shot

Gas Cu. Ft.

Dry Hole

Abandoned

Date

SEP 30 1932

CHAS. L. SHERWOOD Scout