

KANSAS


Barton

FORM 51 5M BRIX

Section 35 Township 20 Range 14W

Well No. #1, C. Weathers

Company Mercury Drilling

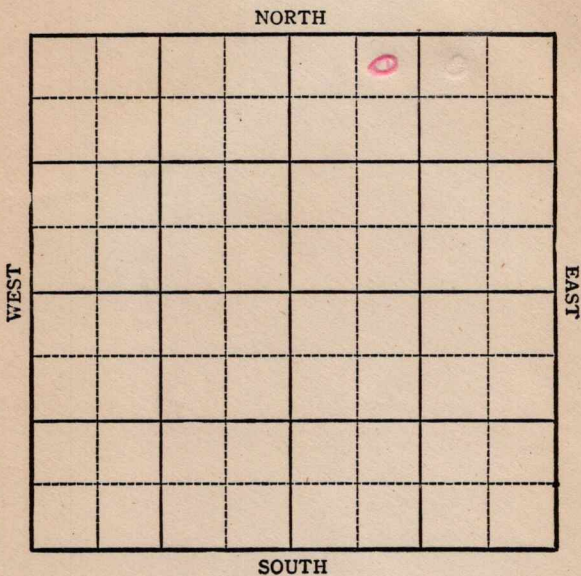

KANSAS

Barton County

Sec. 35 Twp. 20 R. 14W

Well No. #1 C. Weathers Farm

Mercury Drkg. Company


Pritchard

330 Ft. from N. Line

Ft. from S. Line

Ft. from E. Line

990 Ft. from W. Line

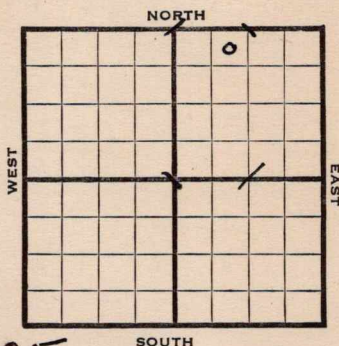

NE NW NE Elev. 1905

1944

# REPORT


7/12 432'  
7/19 8" @ 800 Drlg 2440  
7/26 Lens. 3271  
Arb. 3533 - 48 TD. SO Run ssg.  
8/9 Arb. 3538  
5" @ 3541  
2000 acid  
Water  
TD 3606

ABANDONED

Pool Name PritchardMap No. 82 **KANSAS** Sec. 35 Twp. 20 R. 14WWell No. 1 C. WeathersMercury Drlg. CompanyFIRST REPORT Contractor

NE NW NE

## SECTION PLAT

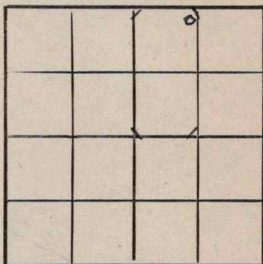330 Ft. from N. Line       Ft. from S. Line       Ft. from E. Line990 Ft. from W. LineBarton CountyLocation                     Rig up                     

Drilling and Remarks:

432'

## RECORD

Cased            in.,            ft.Sand                     Gas                     Oil                     Total Depth                     

## PRODUCTION

1st 24 hrs. Nat.                     1st 24 hrs. after shot                     Gas                      Cu. Ft.Dry Hole                     Abandoned                     

Date

JUL 12 1944 19S. J. LEWIS Scout

Pool Name PritchardMap No. 823 KANSAS Sec. 35 Twp. 20 R. 14 W.Well No. 1 C. WeathersMercury Drlg. CompanyABANDONED Contractor

NE NW NE

## SECTION PLAT

330 Ft. from N. Line         Ft. from S. Line         Ft. from E. Line990 Ft. from W. Line

|  |  |   |  |
|--|--|---|--|
|  |  | 6 |  |
|  |  |   |  |
|  |  |   |  |
|  |  |   |  |

Barton CountyLocation         Rig up         

Drilling and Remarks:

CR 3538.5" @ 35412000 acidNotes.

## RECORD

Cased          in.,          ft.Sand         Gas         Oil         Total Depth 3606

## PRODUCTION

1st 24 hrs. Nat.         1st 24 hrs. after shot         Gas          Cu. Ft.Dry Hole         Abandoned         

Date

AUG 9 1944 19S. J. LEWIS Scout