


Section 36 Township 20 Range 14W

Well No. #5 Spani

Company Phillips  
Hiss

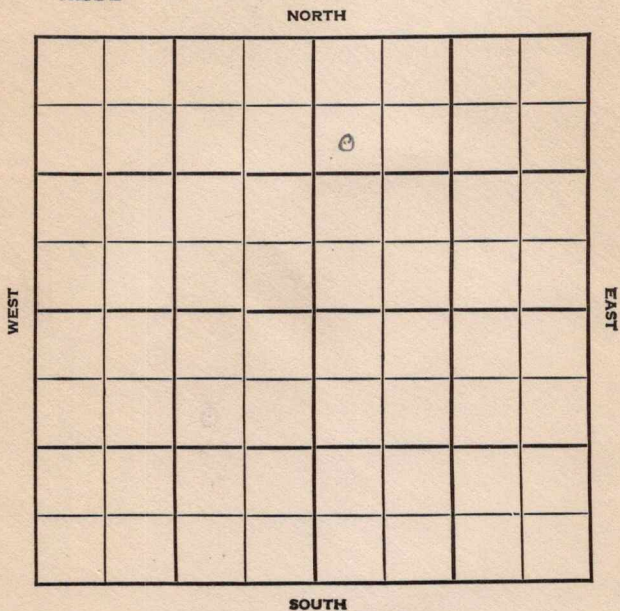

KANSAS

Barton

Sec. 36 Twp. 20 R. 14-W

Well No. #5 Spani Farm

Phillips Company

Hiss Pool


NORTH

990' Ft. from N. Line

\_\_\_\_\_ Ft. from S. Line

\_\_\_\_\_ Ft. from E. Line

330' Ft. from W. Line

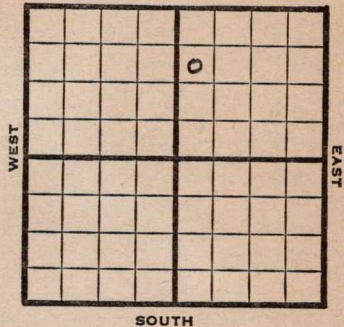

SW NW NE

1947 **Elev. 1912'** REPORT

12/10 **Loc.**

12/17 **RUR**

12/30 **8" @ 803'**  
**Lansing 3216'**  
**Weathered Granite 3435'**  
**Granite 3452-53' TD**  
**Run 5"**

1948  
1/7 "

1/14 "

1/21 "

1/26 "

2/4 "

2/11 "

2/18 "

2/25 "

3/3 "

3/10 "

3/17 "

3/24 **Lans. 3216'** TD **3453'**

**Granite 3452'**

**5" @ 3447'**

**Perf Lans.**

**Bomb Pot. 454'**

**Gr. 38°**

**COMPLETED**

Map No. \_\_\_\_\_ Sec. 36 Twp. 20 R. 14W

Well No. 5 Spani

Phillips Company

FIRST REPORT Contractor

SW NW NE

SECTION PLAT

990 Ft. from N. Line

\_\_\_\_\_ Ft. from S. Line

\_\_\_\_\_ Ft. from E. Line

330 Ft. from W. Line

		Δ	

Barton County

Location X

Rig up \_\_\_\_\_

Drilling and Remarks:

RECORD

Cased \_\_\_\_\_ in., \_\_\_\_\_ ft.

Sand \_\_\_\_\_

Gas \_\_\_\_\_

Oil \_\_\_\_\_

Total Depth \_\_\_\_\_

PRODUCTION

1st 24 hrs. Nat. \_\_\_\_\_

1st 24 hrs. after shot \_\_\_\_\_

Gas \_\_\_\_\_ Cu. Ft.

Dry Hole \_\_\_\_\_

Abandoned \_\_\_\_\_

Date

DEC 1 0 1947

19

S. J. LEWIS

Scout

Map No. 82 Sec. 36 Twp. 20 R. 14W

Well No. 5 Spani

Phillips Company

**COMPLETE** Contractor

SW NW NE

*E. 1912*  
SECTION PLAT

990 Ft. from N. Line

\_\_\_\_\_ Ft. from S. Line

\_\_\_\_\_ Ft. from E. Line

330 Ft. from W. Line

		o	

Barton County

Location \_\_\_\_\_

Rig up \_\_\_\_\_

Drilling and Remarks:

*1 and 3216*  
*Granite 3452.*  
*5" @ 3447*  
*Ref. Name.*  
*Bomb 3454*  
*3528*

RECORD

Cased \_\_\_\_\_ in., \_\_\_\_\_ ft.

Sand \_\_\_\_\_

Gas \_\_\_\_\_

Oil  \_\_\_\_\_

Total Depth 3453

PRODUCTION

1st 24 hrs. Nat. \_\_\_\_\_

1st 24 hrs. after shot \_\_\_\_\_

Gas \_\_\_\_\_ Cu. Ft.

Dry Hole \_\_\_\_\_

Abandoned \_\_\_\_\_

Date

MAR 24 1948 19 \_\_\_\_\_

S. J. LEWIS Scout