

KANSAS


Barton County

FORM 51 5M PETROL

Section 36 Township 20 Range 14W

Well No. 2 Wright

Company Max Cohen

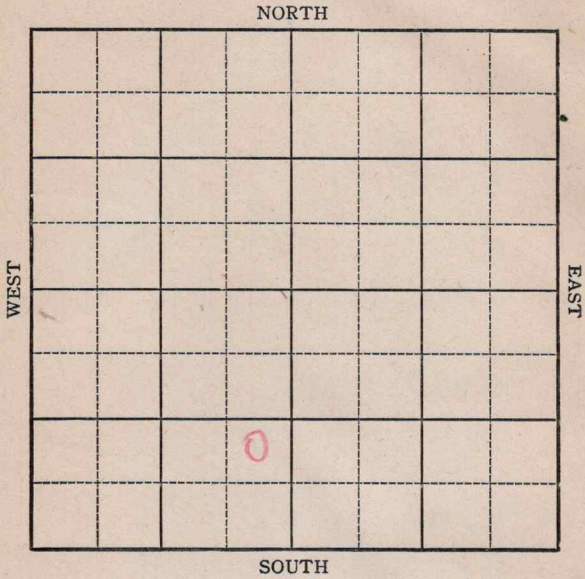

**KANSAS**

Barton

Sec. 36 Twp. 20 R. 14W

Well No. 2 Wright Farm

Max Cohen Company


Wildcat

\_\_\_\_\_ Ft. from N. Line

990 Ft. from S. Line

330 Ft. from E. Line

\_\_\_\_\_ Ft. from W. Line

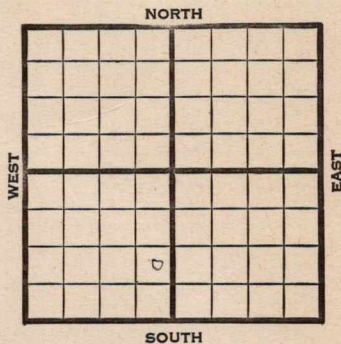

NE SE SW **Elev. 1909**

1945

REPORT

5/16

Location

5/24

10" @ 631

**Anhy**

**780**

Drlg. 1655

5/31

Drlg. 3010'

6/13

**Arb**

**3544**

5' @ 3549'

500 acid.

TD 3588'

**ABANDONED**



