


Section 2 Township 20 Range 15W

Well No. 1 Mull "A"

Company Schermerhorn Oil

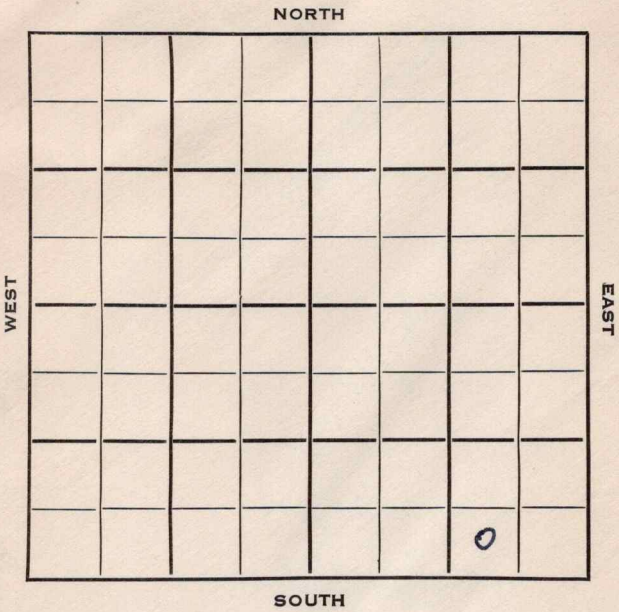

O.W.W.O.

Barton

KANSAS

SEC.	TWP.	R.
2	20	15 W

WELL NO.

1 Mull "A"

FARM

COMPANY

Schermerhorn Oil

CONTRACTOR

Badger

Wildcat


_____ Ft. from N. Line

330 _____ Ft. from S. Line

990 _____ Ft. from E. Line

_____ Ft. from W. Line

SW SE SE

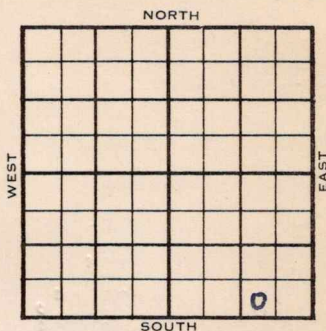

1953

ELEVATION

REPORT

1957'

10/28

Anhy 918' 8" @ 922

Drlg. 1825'

11/4

Spud 10-28-53

D & A

TD 3752'

Anhy 918'

8" @ 922'

Heeb 3242, Doug 3222, Br. Lime 3330',
Lans 3340', B KC 3566, Cong 3580, Sd.
Cong 3614

DST 3606'-34' opn 1 hr, rec 65' mud,
1100#.DST 3606'-36' opn 1½ hr, rec 3 mcfg,
1260' gassy mud 0#.

Arb 3739'

TD 3752'

D & A

ABANDONED

OVER

750665

O.W.W.O.

1954

2/17

Lans 3340', Cong 3580', Arb. 3739'
RUR to WO

2/24

CO 3752' TD
5" @ 3752'

3/3

NR

3/10

"

3/17

"

3/24

"

4/7

SI, Gas

4/14

Gas Well
TD 3752'

Lans 3340', Cong 3580', Arb. 3739'

CO to 3752'

5" @ 3752'

2/3721-22, 2/3713-14, 2/3707-08,

6 3679-82, 2/3658-59

PB 3650

36/3625-31

TD 3752'

Cmp. SI Gas Well

COMPLETED

County Barton State KansasSec. 2 (Blk.) 20 (Sur.) 15W Map No.Operator Schermerhorn OilWell No. 1 Farm Mull "A"Elev. Location SW SE SE330 Ft. From S Line SE990 Ft. From E Line Quarter1st. Report OCT 28 1953

Completion

Remarks

Badger - Contr.

Spudding Date

Drlg. Data WildcatAnhy 918 8" @ 922 drlg. 1825

County Barton State Kansas
 Sec. 2 (Blk. 20 (Sur. 15W Map No.
 (Twp.) (Rge.)
 Operator Schermerhorn Oil
 Well No. 1 Farm Mull "A"
 Elev. 1957 Location SW SE SE



330. Ft. From S Line SE
990 Ft. From E Line Quarter

1st. Report

Completion NOV 4 1953

Remarks Wildcat

Badger - Contr.

Spudding Date 10-28-53

Drlg. Data D & A TD 3752

Anhy 918 8" @ 922 Heeb. 3242

Doug. 3222 Br. lime 3330 Lans. 3340

B KC 3566 Cong. 3580 Sd. cong. 3614

DST 3606-34 open 1 hr. Rec. 65' mud

1100# DST 3606-36 open 1 1/2 hr.

Rec. 3mcfg 1260' gassy mud 0#

Arb. 3739 TD 3752

D & A

J. G. McGEHEE

J. G. McGEHEE

County Barton State Kansas
 Sec. 2 (Blk.) 20 (Sur.) 15W Map No.
 Operator Schermerhorn Oil
 Well No. 1 Farm Mull "A"
 Elev. Location SW SE SE



330 Ft. From S Line SE
990 Ft. From E Line Quarter

1st. Report

Completion APR 1 44 1954

Remarks OWWO

Badger - Contr.

Spudding Date

Drlg. Data Gas well TD 3752

Lens. 3340 Cong. 3580 Arb. 3739

CO to 3752 5" @ 3752 2/ 3721-22

2/ 3713-14 2/ 3707-08 6/ 3679-82

2/ 3658-59 PB 3650 36/ 3625-31 TD 3752

Comp. SI gas well

J. G. McGEHEE