

KANSAS


Barton County

FORM 51 5M PETROL

Section 3 Township 20 Range 15W

Well No. 1 Cameron

Company Stanolind & Mid-Continent Pet.

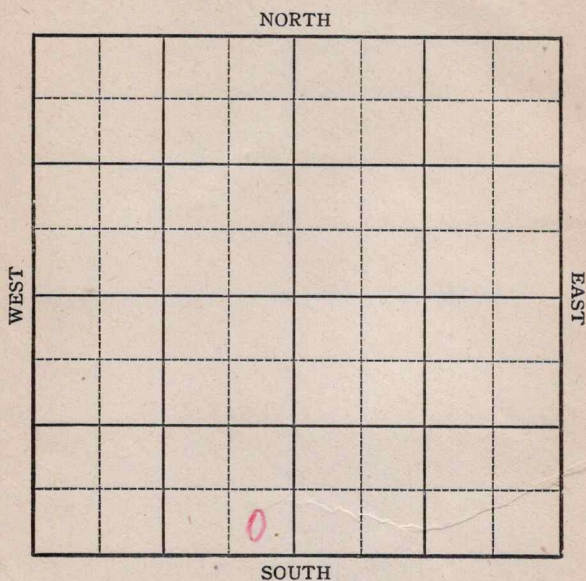

KANSAS

Barton

Sec. 3 Twp. 20 R. 15W

Well No. #1 Cameron Farm

Stanolind & Mid-Continent Petr. Company


_____ Ft. from N. Line

330 Ft. from S. Line

330 Ft. from E. Line

_____ Ft. from W. Line

SE SW **Elev. 1975**

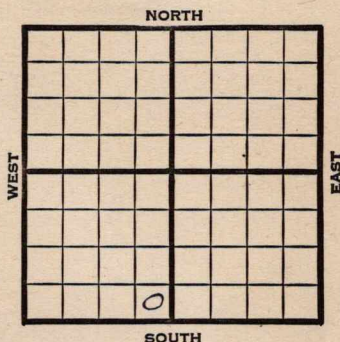

'45

REPORT

- | | |
|------|--|
| 5/16 | Location
Rigging up rotary (Telegram) |
| 5/24 | Spud 5/18/45
13" @ 129
Drlg. 210' |
| 5/31 | 8" @ 958
Anhy 952
Drlg. 1404 |
| 6/6 | Drlg. 2630' |
| 6/7 | Drlg. 3010 |
| 6/9 | Drlg. 3380' |
| 6/12 | Shut down for pump repairs |
| 6/14 | Arbuckle 3679'
Cored 3683-88'
Recovered 3' very spotted
To core ahead.
Running low--does not look very good.
(Telegram) |
| 6/15 | Cored 3688-93'
Rec. 4½'
4' oil staining
Formation pretty tight.
Took D.S.T. 3692'
Open 1 hour
Rec. 85' rotary mud
To core ahead (Tel) |

OVER

750667

#1 Cameron

3-20-15N

1945

6-16 Cored 3693-98' hard dolomite
Cored 3698-3703' hard dolomite
Very small show of dead black oil.
(Telegram)

6-19 Total Depth 3733'
Ran Schlumberger
No shows
Shut down for orders
To abandon (Telegram)

6-21 Shut in; waiting on orders

6/20	Lans	3360
	Cong.	3638
	Arb.	3679
	TD 3733'	

ABANDONED


Kansas Pool Name WildcatMap No. 82 Sec. 3 Twp. 20 R. 15WWell No. 1 CameronStanolind & Mid Cont. ^{Pet.} Company

FIRST REPORT

Contractor

SE SW

SECTION PLAT

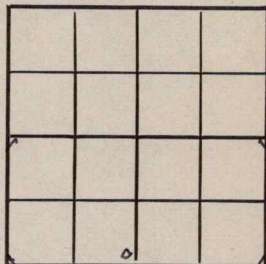 Ft. from N. Line330 Ft. from S. Line330 Ft. from E. Line Ft. from W. LineBartonLocation Rig up

Drilling and Remarks:

RUR

RECORD

Cased in., ft.Sand Gas Oil Total Depth

PRODUCTION

1st 24 hrs. Nat. 1st 24 hrs. after shot Gas Cu. Ft.Dry Hole Abandoned

Date

MAY 16 1945 19 S. J. LEWIS Scout

Kansas Pool Name Wildcat

Map No. _____ Sec. 3 Twp. 20 R. 15W

Well No. 1 Cameron


Stanolind & Mid Continent Pet.
Company

ABANDONED

Contractor

SE SW

E 1/4
SECTION PLAT

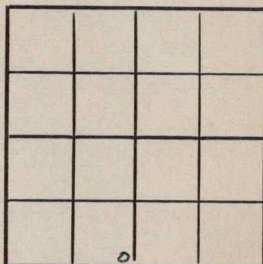

_____ Ft. from N. Line

330 Ft. from S. Line

330 Ft. from E. Line

_____ Ft. from W. Line

Barton County

Location _____

Rig up _____

Drilling and Remarks:

Lans 3360
Aug 3637
Aug 3678

RECORD

Cased _____ in., _____ ft.

Sand _____

Gas _____

Oil _____

Total Depth 3729

PRODUCTION

1st 24 hrs. Nat. _____

1st 24 hrs. after shot _____

Gas _____ Cu. Ft.

Dry Hole _____

Abandoned _____

Date

JUN 20 1945 19

S. J. LEWIS Scout