

Barton

Section 4 Township 20 Range 15W

Well No. #1 Nairn

Company Schermerhorn Oil Company

NORTH

WEST

EAST

							0

SOUTH

Barton **KANSAS** ✓
20 15W

Sec. 4 Twp. R.

Well No. #1 Nairn Farm

Schermerhorn Oil Company

Badger Contractor


Ft. from N. Line

330 Ft. from S. Line

330 Ft. from E. Line

Ft. from W. Line

SE SE NE

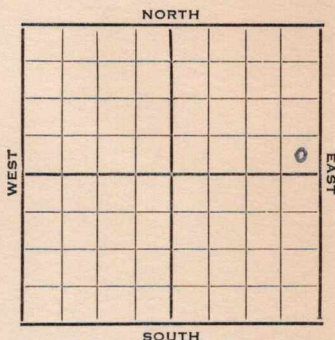

1953 Elev. 1960' REPORT

3/18 RUR
3/26 Anhy 945' 8" @ 980
Drlg. 2300'

4/1 Spud 3-19-53
D & A
TD 3740'
Anhy 945
8" @ 980
Heeb 3250, Tor. 3264, Doug 3278, Br.
Lime 3331, Lans 3341.
DST 3341-3400 open 1 hr. Rec 120' wtr.
1130#
DST 3469-82 open 1 hr. Rec 15' mud
90# Cong 3616,
DST 3626-50 open 1 hr. Rec 30' mud
Arb 3682,
DST 3682-90 open 1 hr. Rec 30' wtr.
1080#
TD 3740'
D & A

ABANDONED

County **Barton** State **Kansas**
 Sec. **4** (Blk. **20**) (Sur. **15W**) Map No.

Operator **Schermerhorn Oil**

Well No. **1** Farm **Nairn**

Elev. Location **SE SE NE**

FIRST REPORT

330 Ft. From **S** Line **NE**

330 Ft. From **E** Line Quarter

1st. Report **MAR 18 1953**

Completion

Remarks

Badger - Contr.

Spudding Date

Drig. Data

RUR

J. G. McGEHEE

County Barton State Kansas
 Sec. 4 (Blk.) 20 (Sur.) 15W Map No.
 Operator Schermerhorn Oil
 Well No. 1 Farm Nairn
 Elev. 1960 Location SE SE NE



330 Ft. From S Line NE

330 Ft. From E Line Quarter

1st. Report

Completion APR 1 1953

Remarks

Badger - Contr.

Spudding Date 3-19-53

Drlg. Data D & A TD 3740

Anhy 945 8" @ 980 Heeb. 3250

Tor. 3264 Doug. 3278 Br. lime 3331

Lans. 3341 DST 3341-3400 open 1 hr.

Rec. 120' wtr. 1130# DST 3469-82

open 1 hr. Rec. 15' mud 99#

Cong. 3616 DST 3626-50 open 1 hr.

Rec. 30' mud Arb. 3682 DST 3682-90

open 1 hr. Rec. 30' wtr. 1080#

TD 3740

D & A

J. G. McGEHEE