


Barton

KANSAS

Section 36 Township 20 Range 11W

Well No. #6 Wright

Company Max Cohen

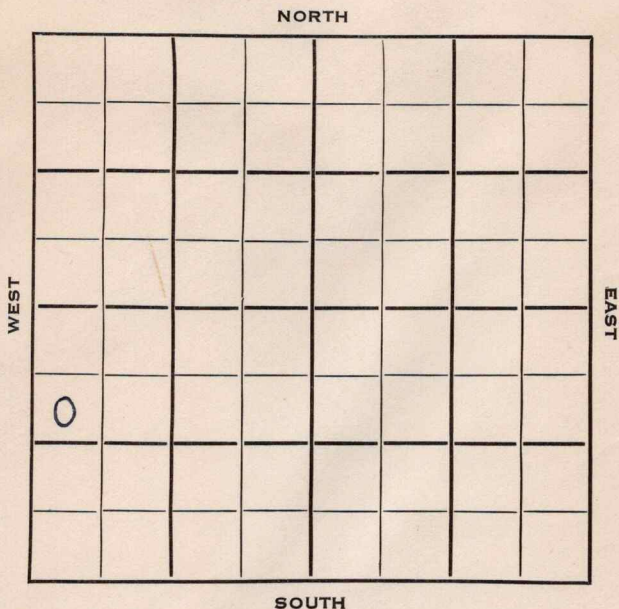

Barton

KANSAS

SEC.	TWP.	R.
36	20	11W ✓

WELL NO.

#6 Wright

FARM

COMPANY

Max Cohen

CONTRACTOR

Walters Drlg.

Pritchard Pool

990


Ft. from N. Line

Ft. from S. Line

Ft. from E. Line

330

Ft. from W. Line

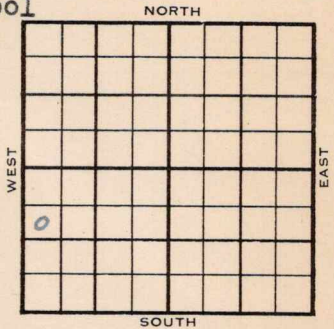

SW NW SW

ELEVATION

REPORT

1953

1903'

10/7
10/14M I R
8" @ 377 Anhy 740'
Drlg. 3132'

10/21

Heeb 3125 Tor 3144 Doug 3161
Br li 3237 Lans 3248
DST 3401-16, 1 hr, 480' frothy oil
900# B KC 3465 Arb. 3486
RTD 3542 5" @ 3541

10/28

CO 3540
60/3489-3533, 1500A
S/12½ BOPH 2 hrs.

11/4

NR

11/11

"

11/18

"

12/2

Spud 10-7-53

Oil Well

TD 3542'

8" @ 377'

Anhy 740', Heeb. 3125', Tor 3144',
Doug 3161', Br lime 3237', Lans 3248
DST 3401-16', opnl hr., rec. 480'
frothy oil, 900#
B KC 3465', Arb. 3486'

TD 3542'

5" @ 3541

CO to 3540

OVER

(Information Brought Forward)

1953

12/2

60/3489-3533, 1500A

S/12 $\frac{1}{2}$ boph

Comp. 342 bopd

COMPLETED

J. G. McGEHEE

J. G. McGEHEE