


Section 2 Township 20 Range 15-W

Well No. #1 Mull

Company Aladdin et al

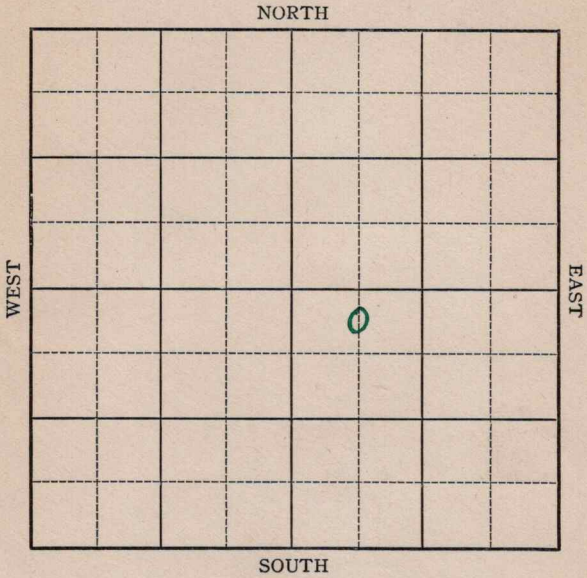



Map No. A-82 Sec. 2 Twp. 20 R. 15W

Well No. 1 Mull

Aladdin etal Company

FIRST REPORT Contractor

C NL NW SE  
330 Ft. from N. Line  
\_\_\_\_\_ Ft. from S. Line  
\_\_\_\_\_ Ft. from E. Line  
660 Ft. from W. Line

SECTION PLAT

		0	

WILDCAT

Location \_\_\_\_\_  
Rig up \_\_\_\_\_  
Drilling and Remarks:

RECORD

Cased \_\_\_\_\_ in., \_\_\_\_\_ ft.  
Sand \_\_\_\_\_  
Gas \_\_\_\_\_  
Oil \_\_\_\_\_  
Total Depth \_\_\_\_\_

PRODUCTION

1st 24 hrs. Nat. \_\_\_\_\_  
1st 24 hrs. after shot \_\_\_\_\_  
Gas \_\_\_\_\_ Cu. Ft.  
Dry Hole \_\_\_\_\_  
Abandoned \_\_\_\_\_

Date

SEP 24 1941

19

S. J. LEWIS

Scout

Barton

KANSAS

Map No. H. 82 Sec. 2 Twp. 20 R. 15W

Well No. 1 Mull

Aladdin etal Company

ABANDONED Contractor

C NL NW SE

SECTION PLAT

330 Ft. from N. Line

\_\_\_\_\_ Ft. from S. Line

\_\_\_\_\_ Ft. from E. Line

660 Ft. from W. Line

		o	

WILDCAT

Location \_\_\_\_\_

Rig up \_\_\_\_\_

Drilling and Remarks:

*CR 83651  
No shows*

RECORD

Cased \_\_\_\_\_ in., \_\_\_\_\_ ft.

Sand \_\_\_\_\_

Gas \_\_\_\_\_

Oil \_\_\_\_\_

Total Depth 3749

PRODUCTION

1st 24 hrs. Nat. \_\_\_\_\_

1st 24 hrs. after shot \_\_\_\_\_

Gas \_\_\_\_\_ Cu. Ft.

Dry Hole \_\_\_\_\_

Abandoned \_\_\_\_\_

Date

OCT 22 1941 19

S. J. LEWIS Scout