


Section 3 Township 20 Range 15W

Well No. #1 Cameron

Company Harms & Knight & C. E. Denman

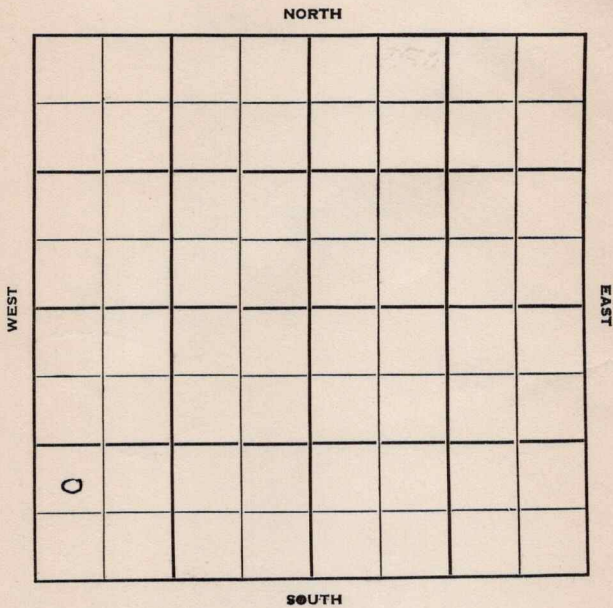

Barton

KANSAS

Sec. 3 Twp. 20 R. 15W

Well No. #1 Cameron Farm

Harms & Knight & C. E. Denman Company

Harms & Knight Contractor
Wildcat


Ft. from N. Line

990 Ft. from S. Line

Ft. from E. Line

330 Ft. from W. Line

NW SW SW

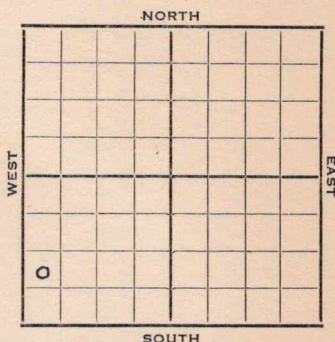

1952

Elev. 1978'

REPORT

1/16

Spud 1-5-52

8" @ 653'

Drlg. 3722'

1/30

Spud 1-5-52

D&A TD 3802

8" @ 653 Top 3048

Heeb. 3301 Tor. 3318

Lans. 3396 BKC 3625

Cong. 3668 Arb. 3706

TD 3802

D&A

ABANDONED

County Barton State Kansas
 Sec. 3 (Blk.) 20 (Sur.) 15W Map No.

Operator Harms & Knight & C. E. Denman

Well No. 1 Farm Cameron

Elev. 1978 Location NW SW SW



990 Ft. From S Line SW

330 Ft. From W Line Quarter

1st. Report JAN 16 1952

Completion

Remarks

Harms & Knight - Contr.

Spudding Date 1-5-52


Drlg. Data

Wildcat

8" @ 653 Drlg. 3722

J. E. TYRA

County Barton State Kansas
 Sec. 3 (Blk. 20 (Sur. 15W Map No.
 (Twp. 20 (Rge. 15W)
 Operator Harms & Knight & C. E. Denman
 Well No. 1 Farm Cameron
 Elev. 1978 Location NW SW SW

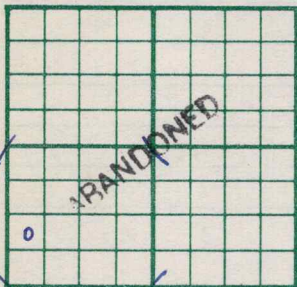

990 Ft. From S Line SW
330 Ft. From W Line Quarter
 Ist. Report
 Completion JAN 30 1952
 Remarks Wildcat
Harms & Knight - Contr.
 Spudding Date 1-5-52

Drlg. Data D & A TD 3802

8" @ 653 Top. 3048 Heeb. 3301

Ter. 3318 Lans. 3396 B KC 3625

Cong. 3668 Arb. 3706 TD 3802

D & A

J. G. McGEHEE