

KANSAS

Barton

Section 3 Township 20 Range 15W

Well No. 1 Fleske

Company Harms & Knight

NORTH

WEST

EAST

SOUTH

Barton
20

KANSAS ✓

15W

3

Sec. _____ Twp. _____ R. _____

#1 Fleske

Well No. _____ Farm

Harms & Knight

Company

Harms & Knight

Wildeat

Contractor

Ft. from N. Line

330

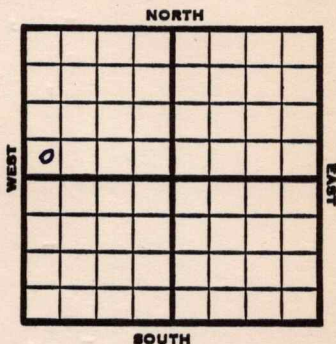
Ft. from S. Line

Ft. from E. Line

330

Ft. from W. Line

SW SW NW



1952 Elev. 1964' REPORT

12/17 Spud 12-14-52

8" @ 915

WOC

12/25 8" @ 915

1/1 Orhg 903 Heeb 3245 Br1 3326 Lans 3334
DST 3462-69 1 hr. 180' oil 60' O&GCM
965A BKC 3563 Cong 3614 Dr1g. 3642

1/8 Arb 3664 RTD 3674 5" @ 3666

1/22 CO 3674, 300A PB
/3457-65 /3470-74, S/5 g free
oil 500 A, O&W sq.

1/29 CO 3490' 16/3457-65 8/3470-74 wtr.

2/5 500A

2/12 S/75 BO 9 hrs., + trace wtr.

2/19 NR

2/26 NR

3/12 NR

3/19 "

OVER

750681

#1 Fleske

1953
3/25

Spud 12-14-52

Oil Well

TD 3674

8" @ 915

Anhy 903, Heeb 3245, Br lime
3326, ans 3334

DST 3462-69, opn 1 hr., rec.
180' oil, 60' o & gcm, 965#

B KC 3563, Cong 3614, Arb.
3664

TD 3674

5" @ 3666

CO to 3674 300A

Perf 3457-65, 3470-74

S/5 gal free oil 500A

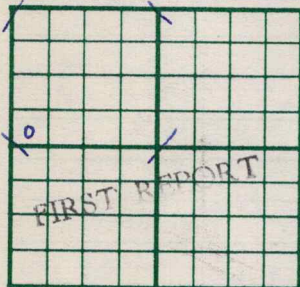
CO to 3490

16/3457-65, 8/3470-74 wtr.
500A

S/75 bo 9 hrs.

Comp. 19 bopd

COMPLETED

County Barton State KansasSec. 3 (Blk.) 20 (Sur.) 15W Map No.Operator Harms & KnightWell No. 1 Farm FleskeElev. Location SW SW NW330 Ft. From S Line NW330 Ft. From W Line Quarter1st. Report DEC 17 1952

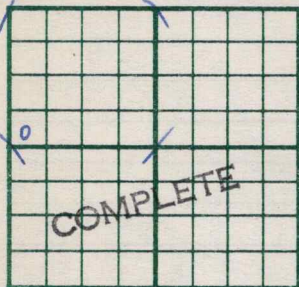
Completion

Remarks

Harms & Knight - Contr.Spudding Date 12-14-52

Drlg. Data

Wilcoat8" @ 915 WOC

County Barton State KansasSec. 3 (Blk.
Twp.) 20 (Sur.
Rge.) 15W Map No.Operator Harms & KnightWell No. 1 Farm FleskeElev. 1964 Location SW SW NW330 Ft. From S Line NW330 Ft. From W Line Quarter

1st. Report

Completion MAR 25 1953Remarks WildcatHarms & Knight - Contr.Spudding Date 12-14-52Drlg. Data Oil well TD 36748" @ 915 Anhy 903 Heeb. 3245Br. lime 3326 Lans. 3334 DST 3462-69open 1 hr. Rec. 180' oil 60' o & gcm965# B KC 3563 Cong. 3614 Arb. 3664TD 3674 5" @ 3666 CO to 3674 300 APerf. 3457-65 3470-74 S/ 5 gal. free oil500 A CO to 3490 16/ 3457-658/ 3470-74 wtr. 500 A S/ 75 bo 9 hr.Comp. 19 bopd

J. G. McGEHEE