
Form 51—5M—3-26—22544

Map No. ____ Sec. 2 Twp. 21 R. 6 W

Well No. 1 Walston Farm

Prairie Oil & Gas Company

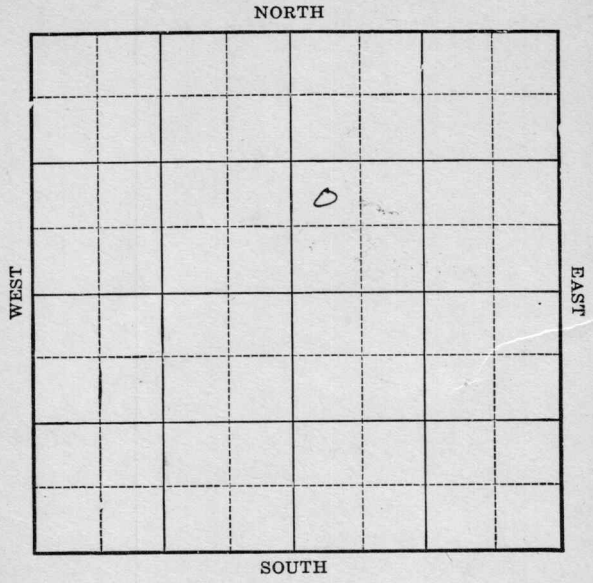

Location ____

Drilling Remarks

Rig Up ____

Drilling Remarks

RECORD

Cased ____ in. ____ ft.

Sand ____

Gas ____

Oil ____

Total Depth ____

PRODUCTION

1st 24 hrs. Nat. ____

1st 24 hrs. after shot ____

Gas ____ cu. ft.

Dry Hole ____

Abandoned ____


Form 252A—5M—11-25—20913

Price

Map No. KAN Sec. 2 Twp. 21 R. 6 W

Well No. 1 Walsten Farm

Prairie Oil & Gas Company

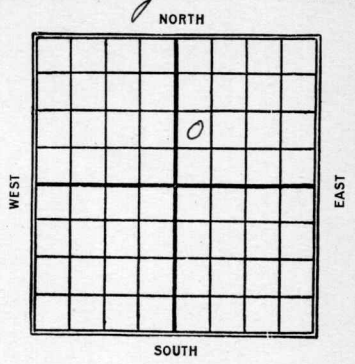

____ Ft. from N. Line

990 Ft. from S. Line

____ Ft. from E. Line

330 Ft. from W. Line

1926

Date	REPORT
8/4	Rig
8/11	—
8/18	—
8/25	rig
8/31	rigging up
9/8	Drlg 820
9/15	" 1012
9/22	" 1875
9/29	" 2210
10/6	T.D. 2210 fishing
10/13	Drlg 2785'
10/20	" 2800'
10/27	" 2940
11/3	" 3060
11/10	" 3135
11/17	" 3325
11/24	Top Chat 3397 Drlg 3414. 1200 ft oil in hole
12/8	Top Chat 3397' 3414 Oil T.D. 3456' 150 bbls nat.

Form 26—1M Bks.—3-23—11959.

no map


Map No. KANSAS / Sec. 2 Twp. 21 R. 6 W

Well No. 1 Halsten

Prairie Oil & Gas Company

Contractor

SECTION PLAT

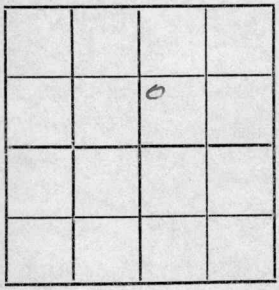

Ft. from N. Line

990 Ft. from S. Line

Ft. from E. Line

330 Ft. from W. Line

FIRST REPORTS

Location

Rig up

Drilling and Remarks:

Rig

RECORD

Cased in., ft.

Sand

Gas

Oil

Total Depth

PRODUCTION

1st 24 hrs. Nat.

1st 24 hrs. after shot

Gas Cu. Ft.

Dry Hole

Abandoned

Date

AUG 4 1926

192

S. J. LEWIS Scout

FORM 26 250 BKS. 4-28 WESTERN

Rice
Kansas
MAP NO. KANSAS SEC. 2 TWP. 21 S R. 6 W


WELL NO. 1 Walsten

Prairie COMPANY

CONTRACTOR

chem cut
can mud

SECTION PLAT

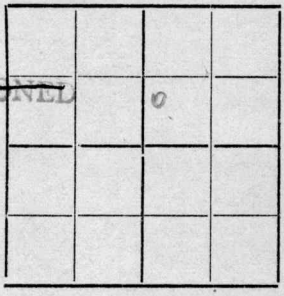

_____ FT. FROM N. LINE ABANDONED

_____ FT. FROM S. LINE

_____ FT. FROM E. LINE

_____ FT. FROM W. LINE

OK

LOCATION

RIG UP

DRILLING AND REMARKS:

3397 } 150 Hbr
3456 }

335

RECORD

CASED _____ IN. _____ FT.

SAND

GAS

OIL

TOTAL DEPTH 3456

PRODUCTION

1ST 24 HRS. NAT.

1ST 24 HRS. AFTER SHOT

GAS _____ CU. FT.

DRY HOLE

ABANDONED

DATE

12/6 1926 SCOUT

Form 26—1M Bks.—3-23—11959.

Rice
Maps


Map No. KANSAS Sec. 2 Twp. 21 R. 6 W

Well No. 1 Webster

Prairie Oil & Gas Company

Contractor

SECTION PLAT

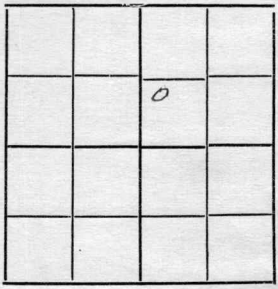

Ft. from N. Line

990 Ft. from S. Line

Ft. from E. Line

330 Ft. from W. Line

COMPLETED

Location

Rig up

Drilling and Remarks:

Top Chat 3397
3414 oil
TD 3456

150 BBL
Nat.

RECORD

Cased in., ft.

Sand

Gas

Oil

Total Depth

PRODUCTION

1st 24 hrs. Nat.

1st 24 hrs. after shot

Gas Cu. Ft.

Dry Hole

Abandoned

Date

DEC 8 - 1926

192

S. J. LEWIS

Scout