


Map No. 100 Sec. 2 Twp. 2 / R. 6 W

Well No. 2 Walsten Farm

Prairie Oil & Gas Company

NORTH

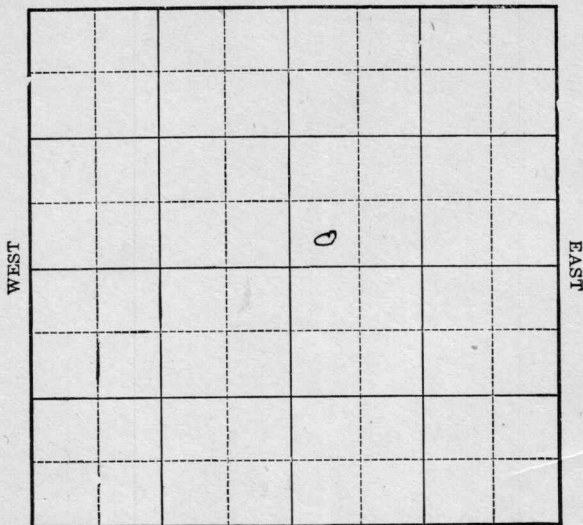

SOUTH

Location _____

Drilling Remarks

Rig Up

Drilling Remarks

RECORD

Cased _____ in. _____ ft.

Sand

Gas

Oil

Total Depth _____

PRODUCTION

1st 24 hrs. Nat.

1st 24 hrs. after shot_____

Gas _____ cu. ft.

Dry Hole

Abandoned -----

Map No. _____ Sec. 2 Twp. 21 R. 6WWell No. 2 Walsten Farm _____Prairie Oil & Gas Company

NORTH

_____ Ft. from N. Line

300 Ft. from S. Line

_____ Ft. from E. Line

300 Ft. from W. Line

WEST

EAST

SOUTH

1926

Date

REPORT

8/4 Rig8/118/18 Spud8/25 Dlg 7009/1 I.D. 700 S.D.9/89/159/229/29 same10/6 same10/13 same10/20 same10/2711/311/1011/1711/2412/112/8 Rigging up12/15 Drlg 900'12/21 " 140012/29 " 1670

~~1927~~

1/5 — T.D. 1670

1/12 - Drlg - 2060

1/19 - " 2265

1/26 - " 2360

2/2 - " 2785

2/9 - " 3025

2/16 - T.D. 3090 - "R. 6"

2/23 - Drlg 3140

3/2 - " 3325

3/9 - Top chat 3387 - T.D. 3408
swabbed 132 bbls. oil, then
all water

3/16 - P.B. to 3404 - swab 6 bbls.
per hr.

3/23 - Top chat 3387

T.D. 3408 - P.B. to

3404 - pumped 30
bbls 24 hrs

Free
no map
 Map No. KANSAS Sec. 2 Twp. 21 R. 6 W

Well No. 2 Valsten
Prairie Oil & Gas Company
 Contractor

SECTION PLAT

-----Ft. from N. Line

300 Ft. from S. Line

-----Ft. from E. Line

300 Ft. from W. Line

		0	

FIRST REPORTS

Location -----

Rig up -----

Drilling and Remarks:

Rig

RECORD

Cased ----- in., ----- ft.

Sand -----

Gas -----

Oil -----

Total Depth -----

PRODUCTION

1st 24 hrs. Nat. -----

1st 24 hrs. after shot -----

Gas ----- Cu. Ft.

Dry Hole -----

Abandoned -----

Date

AUG 4 1926

192

S. J. LEWIS

Scout

Pice
KANSAS
MAP No. SEC. 2 TWP. 21S R. 6W
WELL No. 2 Halster

Primer

COMPANY
CONTRACTOR

check over map
SECTION PLAT

Ft. FROM N. LINE

Ft. FROM S. LINE

Ft. FROM E. LINE

Ft. FROM W. LINE

OK
LOCATION _____

RIG UP _____

DRILLING AND REMARKS:

3383-3408
PB 3404
100 Bbls
33b

RECORD

CASED _____ IN. _____ FT.
SAND _____
GAS _____
OIL *L* _____
TOTAL DEPTH *3404* _____

PRODUCTION

1ST 24 HRS. NAT. _____
1ST 24 HRS. AFTER SHOT _____
GAS _____ CU. FT.
DRY HOLE _____
ABANDONED _____

DATE *3/23* *1* _____ SCOUT
192

Map No. KANSAS Sec. 2 Twp. 21 R. 6WWell No. 2 WalstenPrairie Oil & Gas Company

Contractor

SECTION PLAT

Ft. from N. Line

300 Ft. from S. Line

Ft. from E. Line

300 Ft. from W. Line

		0	

COMPLETED

Location

Rig up

Drilling and Remarks:

Top @ 3387TD 3408Plugged back to3404Pumped 3088 lb
24 hrs.

RECORD

Cased _____ in., _____ ft.

Sand _____

Gas _____

Oil _____

Total Depth _____

PRODUCTION

1st 24 hrs. Nat. _____

1st 24 hrs. after shot _____

Gas _____ Cu. Ft.

Dry Hole _____

Abandoned _____

Date

MAR 23 1927

192

S. J. LEWIS

Scout