
FORM 51

Rice KANSAS

Section 2 Township 21 Range 6 W

Well No. # 1 Walsten "D"

Company H. C. Bennett

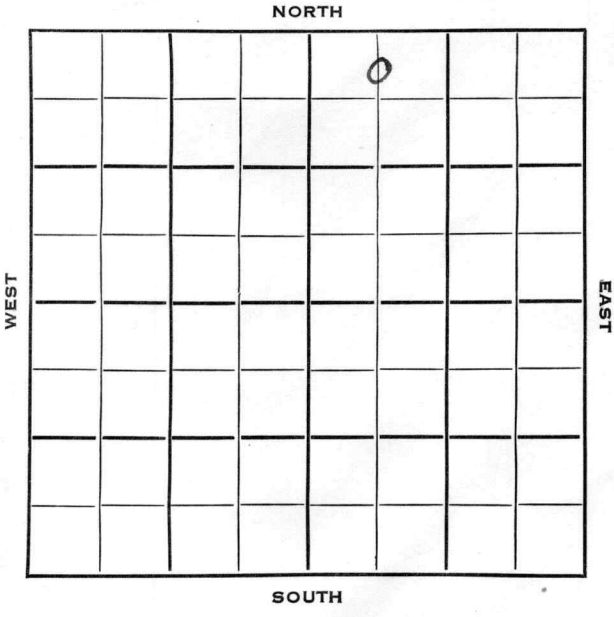

FORM 252-B

Rice

KANSAS

Sec. 2 Twp. 21 R. 6W

Well No. #1 Walsten "D" Farm

H.C. Bennett Company

Salina Drlg. Contractor

Bornholdt Pool


330 Ft. from N. Line

Ft. from S. Line

Ft. from E. Line

660 Ft. from W. Line

C N L NW NE

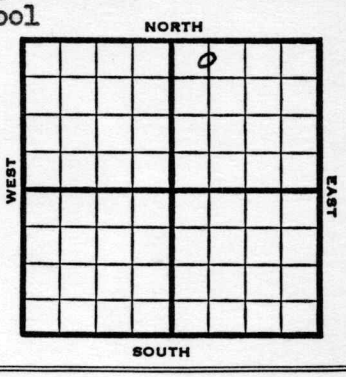

1953 Elev. 1576' REPORT

7/1 Loc.

7/8 8" @ 138
Drlg. 2590'

7/22 Miss 3391
RTD 3394
5" @ 3393'

7/29 NR

8/5 NR

8/12 "

8/19 DD3408 TD
1000' oil, 12 hrs.

8/26 NR

9/2 Spud 7-1-53
Oil Well
TD 3408'
8" @ 138'
Miss 3391'
TD 3394'
5" @ 3393'
DD 3408' FU 1000' oil 12 hr.
Hydro. Comp. 32 bopd.

COMPLETED

FORM 275 FOR SALE BY KANSAS BLUE PRINT CO.


County Rice State Kansas

Sec. 2 (Blk. Twp.) 21 (Sur. Rge.) 6W Map No.

Operator H. C. Bennett

Well No. 1 Farm Walsten "D"

Elev. Location C N L NW NE

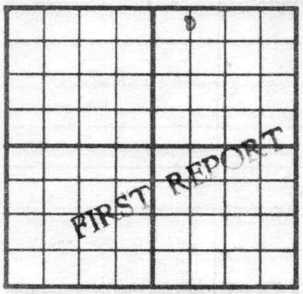

330 Ft. From N Line NE

660 Ft. From W Line Quarter

1st. Report JUL 1 1953

Completion

Remarks

Salina Drlg. - Contr.

Spudding Date

Drlg. Data Bornholdt Pool

Location

J. G. McGEHEE

FORM 275 FOR SALE BY KANSAS BLUE PRINT CO.

County Rice State Kansas

Sec. 2 (Blk. Twp.) 21 (Sur. Rge.) 6W Map No.

Operator H. C. Bennett

Well No. 1 Farm Walsten "D"

Elev. 1576 Location C N L NW NE



330 Ft. From N Line NE

660 Ft. From W Line Quarter

1st. Report

Completion SEP 2 1953

Remarks Bornholdt Pool

Salina Drlg. - Contr.

Spudding Date 7-1-53

Drlg. Data Oil well TD 3408

8" @ 138 Miss. 3391 TD 3394

5" @ 3393 DD 3408 FU 1000' oil 12 hr.

Hydro. Comp. 32 bopd

J. G. McGEHEE