


Section 2 Township 21 Range 6W

Well No. 1 White "C"

Company Sterling Drlg. & Davis-Child

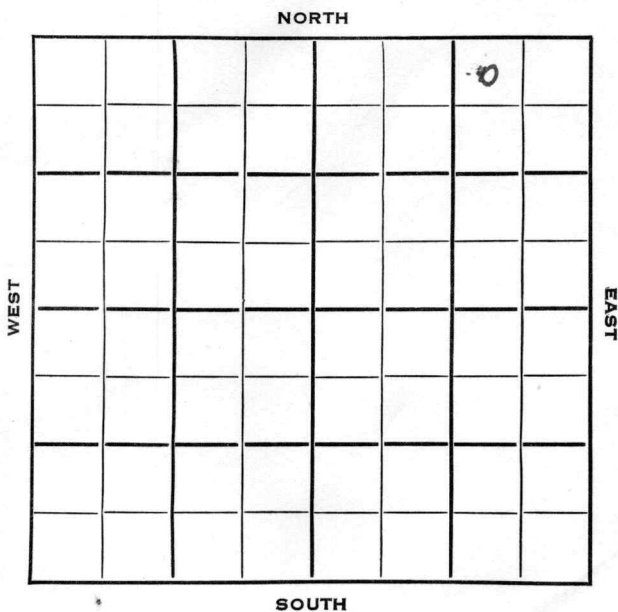

Rice KANSAS

SEC.	TWP.	R.
2	21	6W

WELL NO. 1 White "C" FARM

COMPANY Sterling Drlg. & Davis-Child

CONTRACTOR Sterling Drlg.


Welch-Bornholdt

330 Ft. from N. Line

Ft. from S. Line

990 Ft. from E. Line

Ft. from W. Line

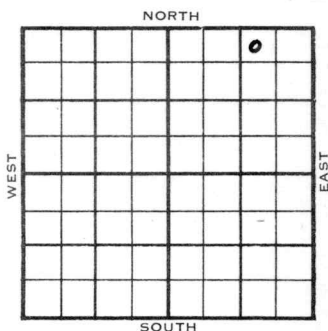

NW NE NE

	ELEVATION	REPORT
1954	1573'	

3/3 Cellar & Pits  
 3/10 8" @ 120' w/100 sks  
 Drlg. 2575'  
 3/17 Br li 2758, Lans 2779', B KC 3284',  
 Cong 3370', Miss 3389'  
 RTD 3392'  
 5" @ 3391'  
 3/24 CO  
 3/31 Spud 3-5-54 Oil well TD 3420'  
 8" @120 Br. lime 2758 Lans 2779  
 B KC 3284 Cong. 3370 Miss 3389  
 TD 3392 5" @ 3391 DD 3420  
 FU 800' oil Hydro. Comp. 25 BOPD  
 15% wtr.

**COMPLETED**



