


Map No. Kansas Sec. 2 Twp. 21 R. 6^W

Well No. 1 Jacobson Farm

United oil & Ref Company

NORTH

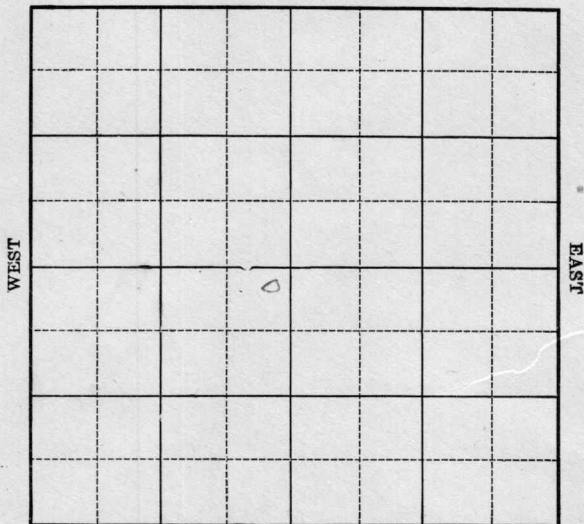

SOUTH

Location _____

Drilling Remarks _____

Rig Up _____

Drilling Remarks _____

RECORD

Cased _____ in. _____ ft.

Sand _____

Gas _____

Oil _____

Total Depth _____

PRODUCTION

1st 24 hrs. Nat. _____

1st 24 hrs. after shot _____

Gas _____ cu. ft.

Dry Hole _____

Abandoned _____

Rice

Map No. Kansas Sec. 2 Twp. 21 R 6 ^W

Well No. 1 Jacobson Farm

United Oil Ref Company

NORTH

300 Ft. from N. Line


Ft. from S. Line

300 Ft. from E. Line

Ft. from W. Line

WEST

EAST

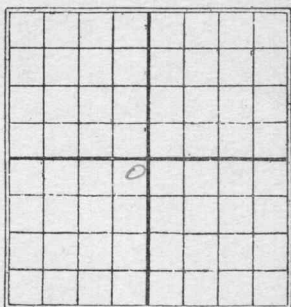

SOUTH

Date

REPORT

192511/25 Location1926

3/4 Top pay 3370 S.D. 3378
to pull big pipe 1800 feet
oil in hole (2nd)

1926

3/25 \$ 3370 Oil 3386 T.D. 3460
Pumped 285 bbls
mkg 6 bbls water

Map No. **KANSAS** Sec. 2 Twp. 21 R. 6 NWell No. 1 JacobsonUnited Oil & Ref. Company

Contractor


SECTION PLAT

300 Ft. from N. Line

Ft. from S. Line

300 Ft. from E. Line

Ft. from W. Line

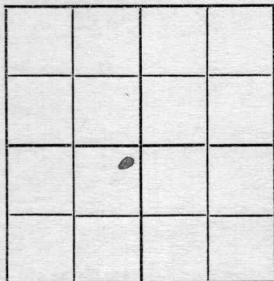

FIRST REPORTS

Location

Rig up

Drilling and Remarks:

Location

RECORD

Cased _____ in., _____ ft.

Sand _____

Gas _____

Oil _____

Total Depth _____

PRODUCTION

1st 24 hrs. Nat. _____

1st 24 hrs. after shot _____

Gas _____ Cu. Ft.

Dry Hole _____

Abandoned _____

Date

NOV 25 1925S. J. LEWIS

Scout

Map No. KANSAS Sec. 2 Twp. 21 R. 6 W

Well No. 1 Jacobson

United Oil & Ref. Company

Contractor

SECTION PLAT

300 Ft. from N. Line

_____ Ft. from S. Line

300 Ft. from E. Line

_____ Ft. from W. Line

COMPLETED

	0		

Location _____

Rig up _____

Drilling and Remarks:

TS 3370

Oil 3386

TD 3460

Pumped 280886

24 hrs.

making 6886

water.

RECORD

Cased _____ in., _____ ft.

Sand _____

Gas _____

Oil _____

Total Depth _____

PRODUCTION

1st 24 hrs. Nat. _____

1st 24 hrs. after shot _____

Gas _____ Cu. Ft.

Dry Hole _____

Abandoned _____

Date

MAR 24 1926

S. J. LEWIS

Scout

Rice
 MAP NO. KANSAS SEC. 2 TWP. 21 S R. 6 E
 WELL NO. 1 Jacob

United Ref COMPANY

CONTRACTOR

*checks with
own map*

SECTION PLAT

_____ FT. FROM N. LINE
 _____ FT. FROM S. LINE
 _____ FT. FROM E. LINE
 _____ FT. FROM W. LINE

OK

LOCATION _____

RIG UP _____

DRILLING AND REMARKS:

*3370 T chat
 oil 3377
 best pay 3388
 to 3444
 200 bbl 3464
 2070 B.S.*

RECORD

CASED _____ IN. _____ FT.
 SAND _____
 GAS _____
 OIL _____
 TOTAL DEPTH 3444

PRODUCTION

1ST 24 HRS. NAT. _____
 1ST 24 HRS. AFTER SHOT _____
 GAS _____ CU. FT.
 DRY HOLE _____
 ABANDONED _____

DATE

3/16 192*4*

SCOUT