


Rice KANSAS

Section 2 Township 21 Range 6-W

Well No. #5 Walsten


Company Phillips

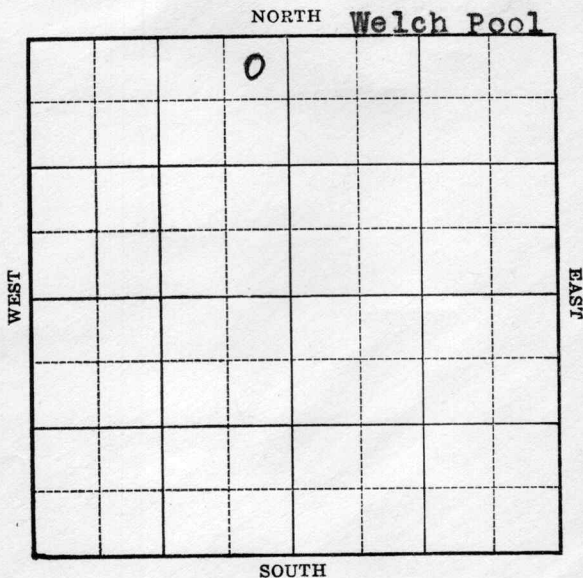

Map No. Rice Sec. 2 Twp. 21 R. 6^WWell No. 5 Walsten FarmIndependent Company

Phillips

NORTH

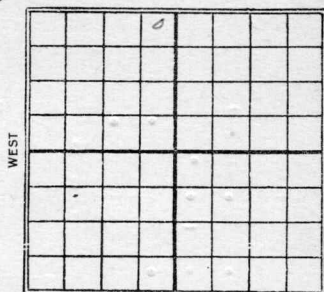

SOUTH

330

~~300~~ Ft. from N. Line

Ft. from S. Line

330

~~300~~ Ft. from E. Line

Ft. from W. Line

Date

REPORT

O. W. D. D

1926

12/29 Rigging up

1927

1/5 Spud

1/12 Spud 140

1/19 Drilling 450

1/26 " 565

2/2 " 900

2/9 " 1490

2/16 " 1900

4/23 " 2295

3/2 " 2565

3/9 " 2790

3/16 " 2885

3/23 " 3015

3/30 " 3115

4/6 T.D. 3150 - U.R. 6"

4/13 Drdg 3240

4/20 Top chat 3392 - T.D. 3395

pulling big pipe

4/27 Top chat 3380 - (S.L.M.)

Drdg 3427 - 2900' oil in hole

5/4 Top chat 3376 - T.D. 3436

130 bbls. oil - 35 bbls. water

OVER

5/11 - Top chat 3380
I.W. 3436
130 bbls oil
35 " water

O. W. D. D

1939

5/31 Old T.D. 3436'
Arb. 3862'
T.D. 4229'
5" - 3867' Cement.
S.W.D.

6/7

OTD 3436
5" 3867
T.D. 4229
Salt water disposal well

ABANDONED

Brookmap
 Map No. **KANSAS** Sec. 2 Twp. 21 R. 6 W

Well No. 5 Haluten

Independence O. & G. Company

Contractor

SECTION PLAT

800 Ft. from N. Line

_____ Ft. from S. Line

300 Ft. from E. Line

_____ Ft. from W. Line

FIRST REPORTS

	0		

Location _____

Rig up _____

Drilling and Remarks:

Rigging up

RECORD

Cased _____ in., _____ ft.

Sand _____

Gas _____

Oil _____

Total Depth _____

PRODUCTION

1st 24 hrs. Nat. _____

1st 24 hrs. after shot _____

Gas _____ Cu. Ft.

Dry Hole _____

Abandoned _____

Date

DEC 29 1926

192

S. J. LEWIS

Scout

MAP No. KANSAS SEC. 2 TWP. 21S R. 6W

WELL No. 5 Halston

COMPANY Independent

CONTRACTOR checks over

SECTION PLAT

_____ FT. FROM N. LINE

_____ FT. FROM S. LINE

_____ FT. FROM E. LINE

_____ FT. FROM W. LINE

LOCATION _____

RIG UP _____

DRILLING AND REMARKS:

3376 } chat
3436 }
100 BBLs
34 x 12
30 BBLs H₂O

RECORD

CASED _____ IN. _____ FT.

SAND _____

GAS _____

OIL _____

TOTAL DEPTH 3436

PRODUCTION

1ST 24 HRS. NAT. _____

1ST 24 HRS. AFTER SHOT _____

GAS _____ CU. FT.

DRY HOLE _____

ABANDONED _____

DATE

2/3 1927 SCOUT

Map No. KANSAS Sec. 2 Twp. 21 R. 6 NWell No. 5 HalstenIndependent Oil Co. Company

Contractor

SECTION PLAT

	0		

200 Ft. from N. Line

Ft. from S. Line

300 Ft. from E. Line

Ft. from W. Line

COMPLETED

Location

Rig up

Drilling and Remarks:

Top Chad 3380TII 3436.1308 ft oil35 " water

RECORD

Cased _____ in., _____ ft.

Sand _____

Gas _____

Oil _____

Total Depth _____

PRODUCTION

1st 24 hrs. Nat. _____

1st 24 hrs. after shot _____

Gas _____ Cu. Ft.

Dry Hole _____

Abandoned _____

Date

MAY 11 1927

S. J. LEWIS

192

Scout

Rice

KANSAS

Map No. 48 Sec. 2 Twp. 21 R. 6WWell No. 5 WalstenPhillips

Company

Contractor

FIRST REPORT

NE NW

330 Ft. from N. Line Ft. from S. Line330 Ft. from E. Line Ft. from W. Line

SECTION PLAT

WELCH POOL

Location Rig up

Drilling and Remarks:

OWDD TD 3436

Arb. 3862

TD 4229

5" @ 3867-Cement

SWD

RECORD

Cased in., ft.Sand Gas Oil Total Depth

PRODUCTION

1st 24 hrs. Nat. 1st 24 hrs. after shot Gas Cu. Ft.Dry Hole Abandoned

Date

MAY 31 1939 19

S. J. LEWIS

Scout

Rice

Map No. 48 Sec. 2 Twp. 21 R. 6WWell No. 5 WalstenPhillips

Company

Contractor

COMPLETED

SECTION PLAT

NE NW

330

Ft. from N. Line

Ft. from S. Line

330

Ft. from E. Line

Ft. from W. Line

WELCH POOL

	0		

Location _____

RECORD

Cased _____ in., _____ ft.

Sand _____

Gas _____

Oil _____

Total Depth 4229

PRODUCTION

1st 24 hrs. Nat. _____

1st 24 hrs. after shot _____

Gas _____ Cu. Ft.

Dry Hole _____

Abandoned _____

Rig up _____

Drilling and Remarks:

*OWDD**Old HD 3436**5" @ 3867**Salt Water**Disposal well*

Date

JUN 7 1939

19

S. J. LEWIS

Scout