

KANSAS

Rice

FORM 51 IOM 12-46 PETROL

Section 3 Township 21 Range 6-W

Well No. #1 Miller


Company Sterling Drlg.

Wherry

NORTH

WEST

EAST

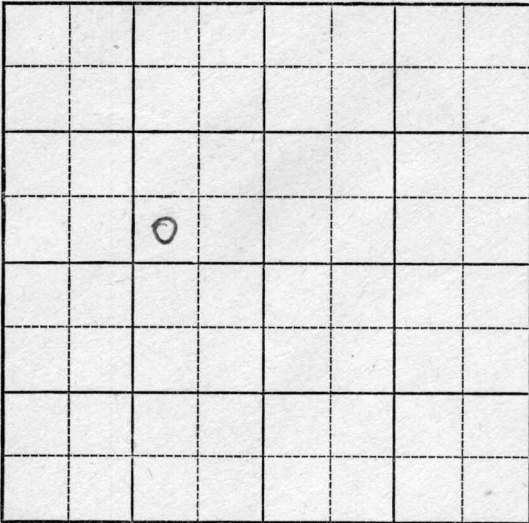

SOUTH

KANSAS

Rice County

Sec. 3 Twp. 21 R. 6-W

Well No. 1 Miller Farm

Sterling Drlg. Company

Wherry Pool

Ft. from N. Line

330


Ft. from S. Line

990

Ft. from E. Line

Ft. from W. Line

SW SE NW

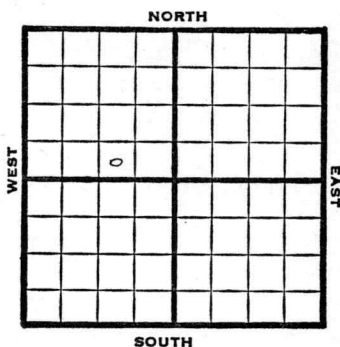

1947

Elev. 1589'

REPORT

8/20

Surface Hole

8/27

8" @ 210'

Drlg. 1350'

9/3

Mississippi 3400'

TD 3402'

5" @ 3400'

RUST

9/10

Miss. 3400'

5" @ 3400'

Pump 150 Pot.

39.0 Gr.

TD 3420'

COMPLETED

Map No. _____ Sec. 3 Twp. 21 R. 6W


Well No. 1 Miller

Sterling Drlg. Company

FIRST REPORT Contractor

SW SE NW

SECTION PLAT

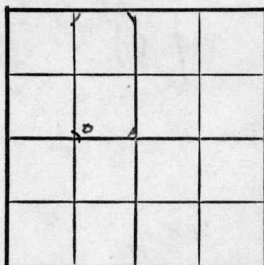

_____ Ft. from N. Line

330 Ft. from S. Line

990 Ft. from E. Line

_____ Ft. from W. Line

Rice County

Location _____

Rig up _____

Drilling and Remarks:

surface hole

RECORD

Cased _____ in., _____ ft.

Sand _____

Gas _____

Oil _____

Total Depth _____

PRODUCTION

1st 24 hrs. Nat. _____

1st 24 hrs. after shot _____

Gas _____ Cu. Ft.

Dry Hole _____

Abandoned _____

Date

AUG 20 1947 19

S. J. LEWIS Scout

Map No. 48 Sec. 3 Twp. 21 R. 6W

Well No. 1 Miller


Sterling Drlg. Company

COMPLETE

Contractor

SW SE NW

E1, N59
SECTION PLAT

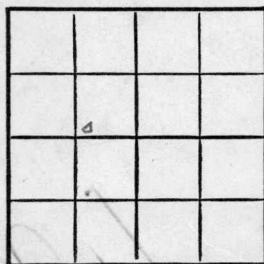

 Ft. from N. Line

330 Ft. from S. Line

990 Ft. from E. Line

 Ft. from W. Line

Rice County

Location

Rig up

Drilling and Remarks:

Miss 3400'
5" @ 3400'
Pump 150 BT

890' L

RECORD

Cased in., ft.

Sand

Gas

Oil

Total Depth 8420

PRODUCTION

1st 24 hrs. Nat.

1st 24 hrs. after shot

Gas Cu. Ft.

Dry Hole

Abandoned

Date

SEP 10 1947

19

S. J. LEWIS

Scout