


Section 3 Township 21 Range 6W

Well No. #3 Miller

Company Sterling Drlg.

Welch

NORTH

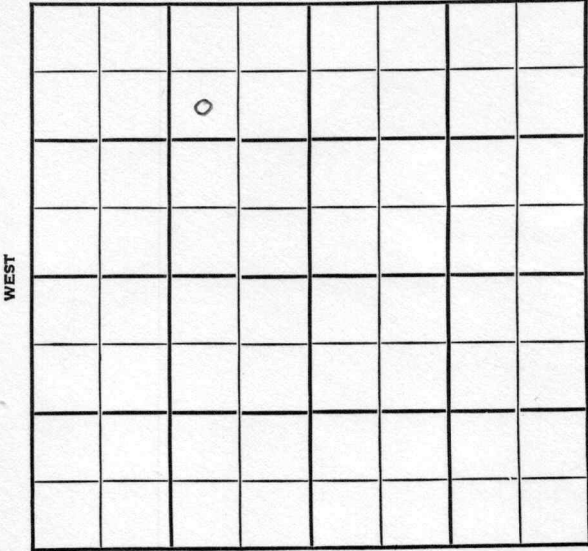

SOUTH

Sec. 3 Twp. 21 R. 6W

Well No. #3 Miller Farm _____

Sterling Drlg. Company _____

Welch


990 Ft. from N. Line

_____ Ft. from S. Line

990 Ft. from E. Line

_____ Ft. from W. Line

SW NE NW

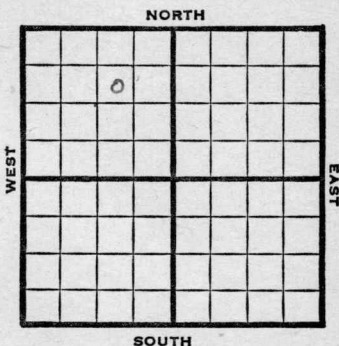

1947

Elev. 1584' REPORT

10/15

10" @ 90'

WOC

10/22

Drlg. 2880'

10/29

Mississippi 3372'

TD 3374'

Running casing

11/5

5" @ 3373'

RUST

11/12

TD 3417' - 2500' fluid 2 hrs.

11/19

"

11/25

"

12/3

Miss 3372'

5" @ 3373'

Pump 40 Pot

Total 3417'

Gr. 36°

COMPLETED

Map No. _____ Sec. 3 Twp. 21 R. 6W

Well No. 3 Miller

Sterling Drlg. Company

FIRST REPORT Contractor

SW NE NW

SECTION PLAT

990 Ft. from N. Line

_____ Ft. from S. Line

990 Ft. from E. Line

_____ Ft. from W. Line

Rice County

Location _____

Rig up _____

Drilling and Remarks:

'10" @ 90 WOE

RECORD

Cased _____ in., _____ ft.

Sand _____

Gas _____

Oil _____

Total Depth _____

PRODUCTION

1st 24 hrs. Nat. _____

1st 24 hrs. after shot _____

Gas _____ Cu. Ft.

Dry Hole _____

Abandoned _____

Date

OCT 15 1947 19

S. J. LEWIS Scout

