


Section 3 Township 21 Range 6WWell No. 6 MillerCompany Phillips

NORTH

WEST

EAST

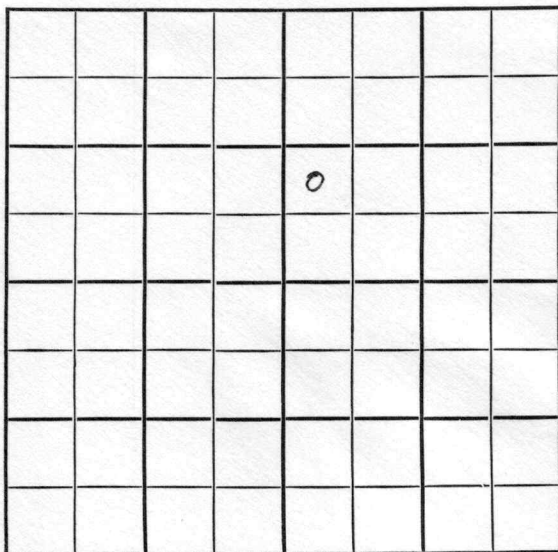

SOUTH

Rice

KANSAS

Sec. 3 Twp. 21 R. 6W

Well No. #6 Miller Farm

Phillips Company

Welch


Ft. from N. Line

990 Ft. from S. Line

Ft. from E. Line

330 Ft. from W. Line

NW SW NE

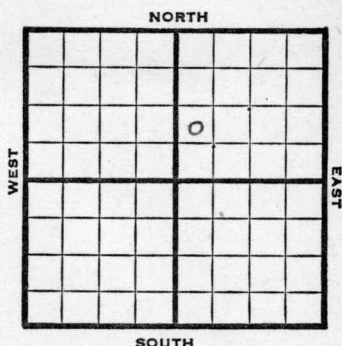

1947

Elev. 1574' REPORT

12/23

RUR

12/30

8" @ 261'
Drlg. 2290'

1948

1/7

Mississippi 3364'
TD 3368'
5" @ 3364'
RUST

1/14

TD 3385'
Swb 45 bbls oil 1 hr

1/21

"

1/28

Miss. 3364'
5" @ 3364'
Pump 135 Pot
36.0 Gr.
TD 3385'
Comp.

COMPLETED

Map No. _____ Sec. 3 Twp. 21 R. 6W

Well No. 6 Miller

Phillips Company

FIRST REPORT

Contractor _____

NW SWNE

SECTION PLAT

_____ Ft. from N. Line

990 Ft. from S. Line

_____ Ft. from E. Line

330 Ft. from W. Line

		a	

Rice County

Location _____

Rig up _____

Drilling and Remarks:

R U R

RECORD

Cased _____ in., _____ ft.

Sand _____

Gas _____

Oil _____

Total Depth _____

PRODUCTION

1st 24 hrs. Nat. _____

1st 24 hrs. after shot _____

Gas _____ Cu. Ft.

Dry Hole _____

Abandoned _____

Date

DEC 23 1947 19

S. J. LEWIS Scout

Map No. 48 Sec. 3 Twp. 21 R. 6W

Well No. 6 Miller

Phillips Company

COMPLETE Contractor

NW SW NE

E 1574
SECTION PLAT

 Ft. from N. Line

990 Ft. from S. Line

 Ft. from E. Line

330 Ft. from W. Line

		0	

Rice County

Location

Rig up

Drilling and Remarks:

Miss 8364
5' 10" 8364
Pump 135 BX

86 2/3

RECORD

Cased in., ft.

Sand

Gas

Oil ✓

Total Depth 8985

PRODUCTION

1st 24 hrs. Nat.

1st 24 hrs. after shot

Gas Cu. Ft.

Dry Hole

Abandoned

Date

JAN 28 1948

19

S. J. LEWIS

Scout