

Barton

Section 7 Township 20 Range 12WWell No. 1 SchartzCompany Bay Pet.Wildcat
NORTH

WEST									EAST

SOUTH

Sec. 7 Twp. 20 R. 12-W ✓

Well No. #1 Schartz Farm

Bay Pet.

Company

Wildcat


 Ft. from N. Line

330 Ft. from S. Line

 Ft. from E. Line

330 Ft. from W. Line

SW SE

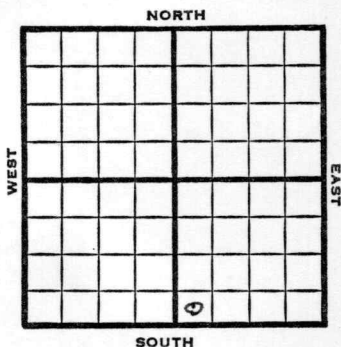

1948 Elev 1853' REPORT

11/3 Location

11/10 "

11/16 RUR

11/23 Drlg 160'

11/30 8"@ 362'

Topeka 2850'

Drlg 302 0'

12/6 Lansing 3172' Arbuckle 3423'

TD 3426

5" @ 3424'

12/15 TD 3433'

Plug 3280

24 shots 3280-34 1000 acid

Swb 6 bbls oil PH

12/22 "

12/29 "

1949

1/12 TD 3433'

Arb. 3423'

Lansing 3172'

5"@ 3424'

Perf Lans 1000 acid

Pump 302 oil Pot

41° Gr.

Comp

COMPLETED


Map No. _____ Sec. 7 Twp. 20 R. 12WWell No. 1 SchartzBay Pet. Company _____

FIRST REPORT

Contractor _____

SW SE

SECTION PLAT

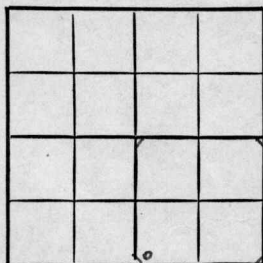

_____ Ft. from N. Line

330 Ft. from S. Line

_____ Ft. from E. Line

330 Ft. from W. LineBarton CountyLocation X

Rig up _____

Drilling and Remarks:

RECORD

Cased _____ in., _____ ft.

Sand _____

Gas _____

Oil _____

Total Depth _____

PRODUCTION

1st 24 hrs. Nat. _____

1st 24 hrs. after shot _____

Gas _____ Cu. Ft.

Dry Hole _____

Abandoned _____

Date

NOV 3 1948 19S. J. LEWIS Scout

Kansas

Wildcat

Map No. 46 Sec. 7 Twp. 20 R. 12WWell No. 1 Schartz

Bay Pet.


Company

COMPLETE

Contractor

SW SE

SECTION PLAT

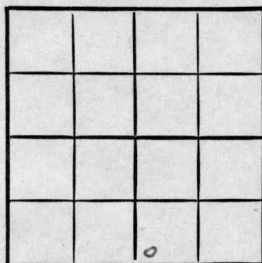 Ft. from N. Line330 Ft. from S. Line Ft. from E. Line330 Ft. from W. Line

Barton County

RECORD

Location

Cased in., ft.

Rig up

Sand

Drilling and Remarks:

Gas

Oil ☒Total Depth 3423

PRODUCTION

1st 24 hrs. Nat. 1st 24 hrs. after shot Gas Cu. Ft.Dry Hole Abandoned

Date

JAN 12 1949 19

S. J. LEWIS

Scout