


Section 21 Township 20 Range 13W

Well No. #2 Sandrock

Company Schermerhorn Oil

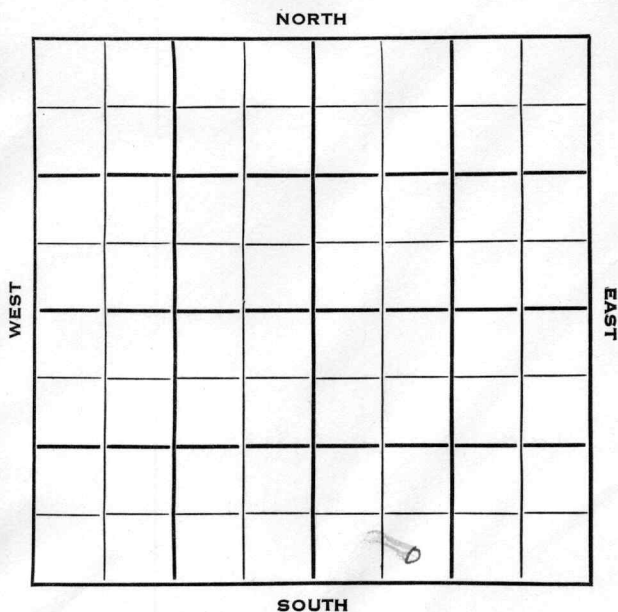

Barton  
20

KANSAS ✓  
13W

Sec. 21 Twp. \_\_\_\_\_ R. \_\_\_\_\_

Well No. #2 Sandrock Farm \_\_\_\_\_

Schermerhorn Oil Company \_\_\_\_\_

Adkins Contractor \_\_\_\_\_


\_\_\_\_\_ Ft. from N. Line

330 Ft. from S. Line

\_\_\_\_\_ Ft. from E. Line

990 Ft. from W. Line

SE SW SE

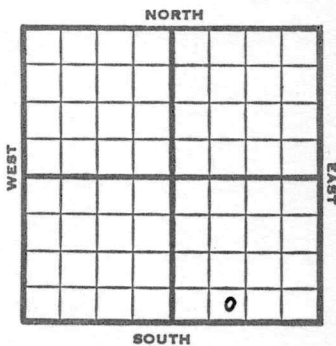

1953 Elev. 1886' REPORT

2/4 RUR

2/12 8" @ 245  
Shut down 2867

~~2/19~~ TD 3590  
D&A

2/25 Spud 2-3-53  
D&A

TD 3590

8" @ 245

Heeb 3141, Tor 3161, Doug 3175,  
Br lime 3260, Lans 3271, Cong  
3515, Arb 3586

TD 3590

D&A

**ABANDONED**



