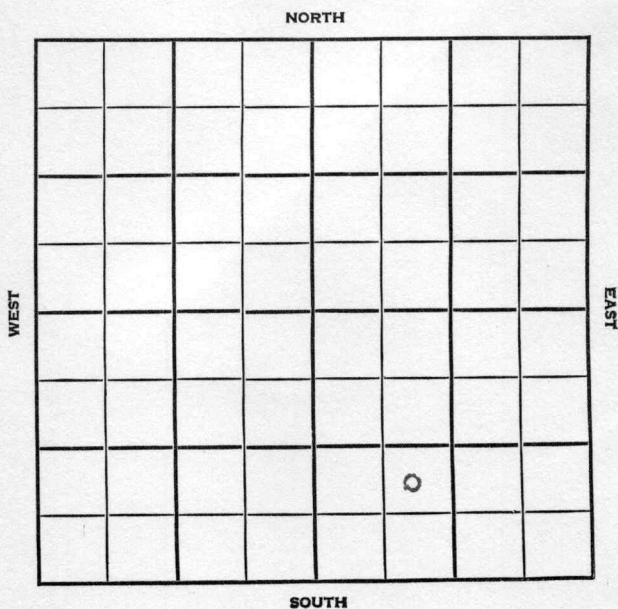


Section 23 Township 20 Range 13WWell No. 1 FrybergerCompany A. R. Jones

Barton

KANSAS

SEC.	TWP.	R.
23	20	13W

WELL NO.

#1 Fryberger.

FARM

COMPANY

A.R. Jones

CONTRACTOR

Garvey

SW Sunny Valley Pool

NORTH

Ft. from N. Line


990

Ft. from S. Line

Ft. from E. Line

990

Ft. from W. Line

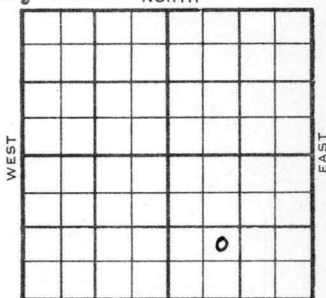

NE SW SE

1954

ELEVATION

1868'

REPORT

12/22

MIR

1955

1/12

Spud 12-21-54 - D&A

TD 3543'

8-5/8" @ 252'

Heeb. 3102', Br line 3218', Lans
3232'DST 3220-65', opn 1 hr., rec. 25' mud,
O#


Cong. 3465', Arb. 3527'

DST 3527-37', opn 1 hr., rec. 15' mud,
490#

TD 3543'

D&A

ABANDONED

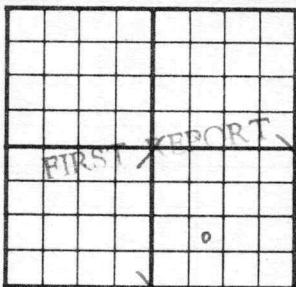County **Barton** State **Kansas**Sec. **23** (Blk. Twp.) **20** (Sur. Rge.) **13W** Map No.Operator **A. R. Jones**Well No. **1** Farm **Fryberger**Elev. Location **NE SW SE**990 Ft. From **S** Line **SE**990 Ft. From **W** Line Quarter1st. Report **DEC 22 1954**

Completion


Remarks

Garvey - Contr.

Spudding Date

Drlg. Data **SW Sunny Valley Pool****M I R**

FABEN GILSTRAP

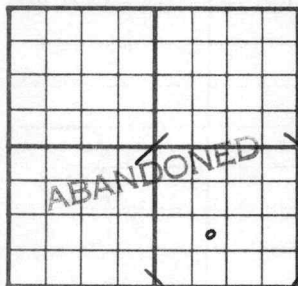County Barton State KansasSec. 23 (Blk. 20 (Sur. 13W Map No.)
(Twp.) (Rge.)Operator A. R. JonesWell No. 1 Farm FrybergerElev. 1868 Location NE SW SE

990 Ft. From S Line SE

990 Ft. From W Line Quarter

1st. Report

Completion JAN 1 2 1955Remarks SW Sunny Valley PoolGarvey - Contr.Spudding Date 12-21-54Drig. Data D & A TD 35438 5/8" @ 252 Heeb. 3102 Br. lime 3218Lans. 3232 DST 3220-65 open 1 hr.Rec. 25' mud 0# Cong. 3465 Arb. 3527DST 3527-37 open 1 hr. Rec. 15' mud490# TD 3543D & A

FABEN GILSTRAP