


Section 24 Township 20 Range 13^WWell No. 1 BatchmanCompany Harms-Burt Drlg.

NORTH

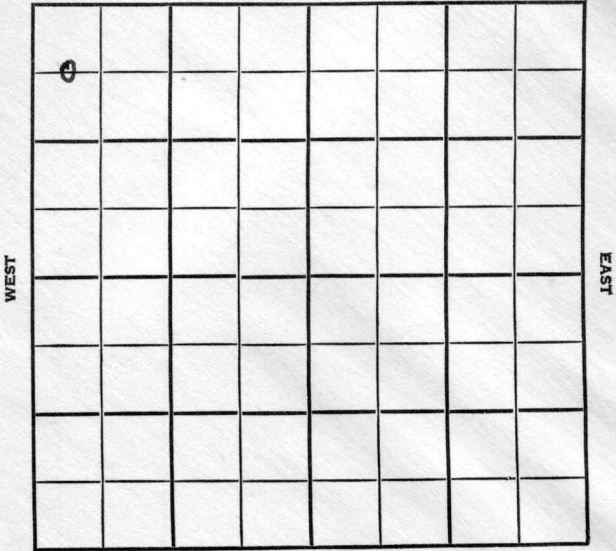

SOUTH

Barton KANSAS

SEC.	TWP.	R.
24	20	13W
WELL NO. #1 Batchman		
FARM		

COMPANY Harms-Burt Drlg.

CONTRACTOR

Co. Tools.


SW Sunny Valley Pool

660 _____ Ft. from N. Line

_____ Ft. from S. Line

_____ Ft. from E. Line

330 _____ Ft. from W. Line

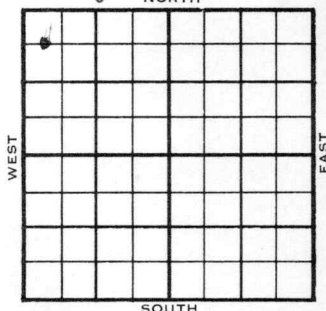

C W $\frac{1}{2}$ NW NW

1955	ELEVATION 1860'	REPORT
------	---------------------------	--------

3/9 M I R

3/23 Spud 3-9-55, D&A, TD 3520,
 8" @ 200, Anhy 680, Heeb 3088
 Tor 3109, Br. Lime 3207, Lans
 3220, DST 3259-3313, open 20
 min. Rec 10' mud, 1035#,
 Doug 3125, B KC 3448, Cong 3457
 Arb 3509, TD 3520,
 D&A

ABANDONED

Well No. **1** Farm **Batchman**

Elev.	Location	C W $\frac{1}{2}$ NW NW
-------	----------	-------------------------

FIRST REPORT

660 Ft. From N Line NW

330 Ft. From W Line Quarter

1st. Report MAR 9 1955

Completion

Remarks


Co. tools

Spudding Date _____

Drlg. Data SW Sunny Valley Pool

M I R

FABEN GILSTRAP

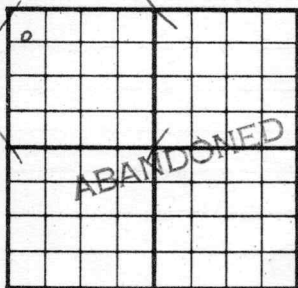County Barton State KansasSec. 24 (Blk. 20) (Sur. 13W) Map No.Operator Harms-Burt Drlg.Well No. 1 Farm BatchmanElev. 1860 Location C W $\frac{1}{2}$ NW NW660 Ft. From N Line NW330 Ft. From W Line Quarter

1st. Report

Completion MAR 23 1955Remarks SW Sunny Valley PoolCo. toolsSpudding Date 3-9-55Drlg. Data D & A TD 35208" @ 200 Anhy 680 Heeb. 3088Tor. 3109 Br. lime 3207 Lans. 3220DST 3259-3313 open 20 min. Rec. 10' mud1035# Doug. 3125 B KC 3448Cong. 3457 Arb. 3509 TD 3520D & A

FABEN GILSTRAP