

KANSAS


BARTON

FORM 51 5M 11-44 PETROL

Section 25 Township 20 Range 13 W

Well No. #1 Hofmeister

Company W. L. HARTMAN

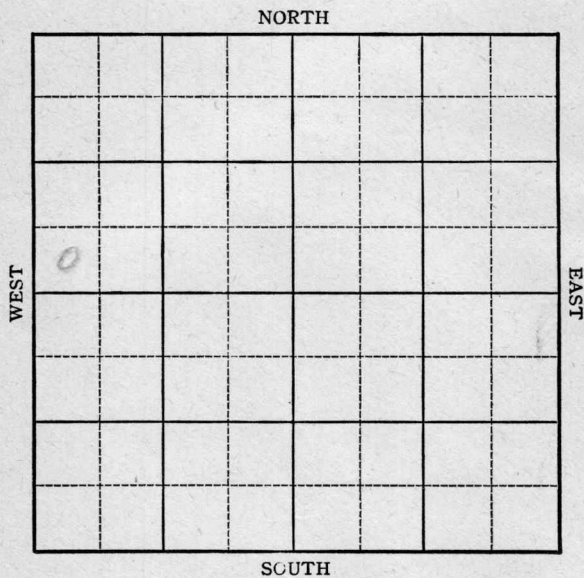

Barton County

KANSAS

Sec. 25 Twp. 20 R. 13W

Well No. #1 Hofmeister Farm

W. L. Hartman Company


Wildcat

Ft. from N. Line

330 Ft. from S. Line

Ft. from E. Line

330 Ft. from W. Line

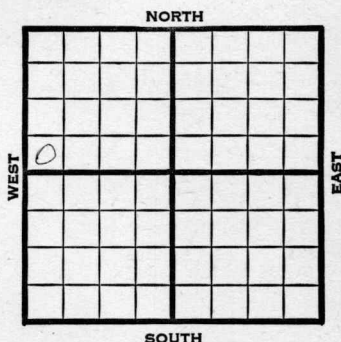

SW NW

1945

Elev. 1863

R E P O R T

4/11

SH

4/20

8" @ 375
2567' fsg.

4/25

Lans 3252
Cong 3471
Simp 3520
Arb. 3541
TD 3595'

ABANDONED

Kansas Pool Name Wildcat

Map No. 82 Sec. 25 Twp. 20 R. 13W

Well No. 1 Hofmeister

W. L. Hartman Company

FIRST REPORT Contractor

SW NW


SECTION PLAT

 Ft. from N. Line

330 Ft. from S. Line

 Ft. from E. Line

330 Ft. from W. Line

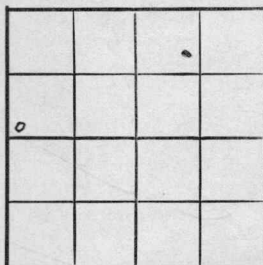

Barton

Location

Rig up

Drilling and Remarks:

SH

RECORD

Cased in., ft.

Sand

Gas

Oil

Total Depth

PRODUCTION

1st 24 hrs. Nat.

1st 24 hrs. after shot

Gas Cu. Ft.

Dry Hole

Abandoned

Date

APR 11 1945

19

S. J. LEWIS

Scout

Kansas Pool Name WildcatMap No. 82 Sec. 25 Twp. 20 R. 13WWell No. 1 HofmeisterW. L. Hartman Company


ABANDONED

Contractor

SW NW

E 1/8 S

SECTION PLAT

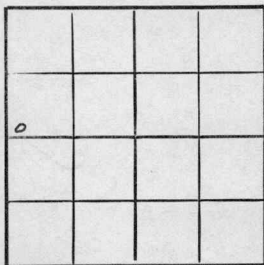 Ft. from N. Line330 Ft. from S. Line Ft. from E. Line330 Ft. from W. LineBarton CountyLocation Rig up

Drilling and Remarks:

Lans 3252Coalg 3471Shaly 3520Car 43541

RECORD

Cased in., ft.Sand Gas Oil Total Depth 3595

PRODUCTION

1st 24 hrs. Nat. 1st 24 hrs. after shot Gas Cu. Ft.Dry Hole Abandoned

Date

APR 25 1945

19

S. J. LEWIS Scout