

KANSAS


Barton County

FORM 51 5M PETROL

Section 6 Township 20 Range 15W

Well No. 2 Behrens

Company Solar Oil

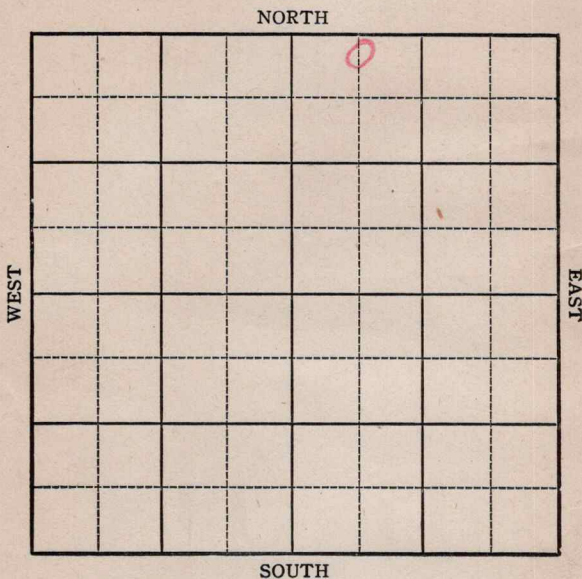

Sec. 6 Twp. 20 R. 15W

Well No. #2 Behrens Farm


Solar Oil Company

330 Ft. from N. Line

 Ft. from S. Line

 Ft. from E. Line

585 Ft. from W. Line

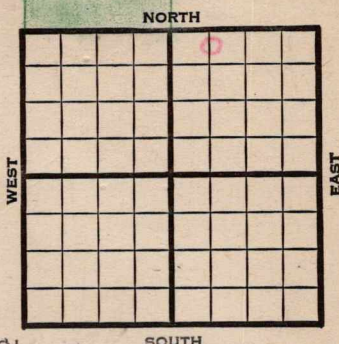

C N L NW NE Elev. 1984

1945

REPORT

- 6-6 Drilling 1100'
- 6-20 Arbuckle 3643'
Total Depth 3755
Show of oil.
5" cemented @ 3753'
Waiting (Telegram)
Running 11' higher than #1 Behrens
South Offset. on the Arbuckle.
- 6-27 Top Arbuckle 3643'
Total Depth 3755'
Set 5" @ 3753'
Perforated 25 shots 3701-09'
250' oil 3 hours. Natural
Will test. (Tel)
- 6/14 Drilg. 2600'
- 6/21 Arb 3643
TD 3755
5" @ 3753 SO RUST
- 6/28 25 shots 3701-09
250' oil 3 hrs
- 7/3 48 shots 3705-3722½ No Inc.
1000 acid. No increase
- 7/11 30 shots 3718-3724½ 1000 acid.
2½ M Gas
Flow 18 oil a day
- 7/19 Shut down.
- 7/26 " "
- 8/1 " "
- 8/8 " "
- 8/15 " "
- 8/22 " "

OVER

750847

1945

8/29

Shut down

9/5

Arb. 3643

5" @ 3753

Perf. Arb. 2000 acid

TD 3755

Pump 18 oil Pot.

2 M Gas

Grav. 39.9

COMPLETED

Kansas Pool Name BehrensMap No. 82 Sec. 6 Twp. 20 R. 15WWell No. 2 BehrensSolar Oil CompanyFIRST REPORT Contractor

C N L NW NE

SECTION PLAT

330 Ft. from N. Line Ft. from S. Line Ft. from E. Line585 Ft. from W. Line
offset

		o	

Barton

Location Rig up

Drilling and Remarks:

Anhy 990'
8"-1000 WOC

RECORD

Cased in., ft.Sand Gas Oil Total Depth

PRODUCTION

1st 24 hrs. Nat. 1st 24 hrs. after shot Gas Cu. Ft.Dry Hole Abandoned

Date

JUN 6 1945 19 S. J. LEWIS Scout


KANSAS

Kansas Pool Name BehrensMap No. 82 Sec. 6 Twp. 20 R. 15WWell No. 2 BehrensSolar Oil Company

COMPLETED

Contractor

C N L NW NE

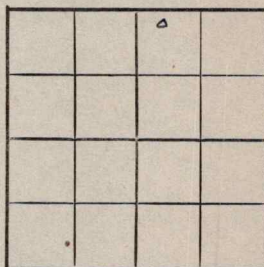E 1/1984
SECTION PLAT330 Ft. from N. Line Ft. from S. Line Ft. from E. Line585 Ft. from W. LineBarton CountyLocation Rig up

Drilling and Remarks:

Cor 83648
5' to 3753
Perf Cor
2000 acid
Pump 18 oil Rd
20M Gas

RECORD

Cased in., ft.Sand Gas Oil Total Depth 0225

PRODUCTION

1st 24 hrs. Nat. 1st 24 hrs. after shot Gas Cu. Ft.Dry Hole Abandoned

Date

SEP 5 1945 19S. J. LEWIS Scout