


Map No. Kansas Sec. 17 Twp. 24 R. 13
 Well No. 1 Winchman Farm
J. S. Davis Company

NORTH

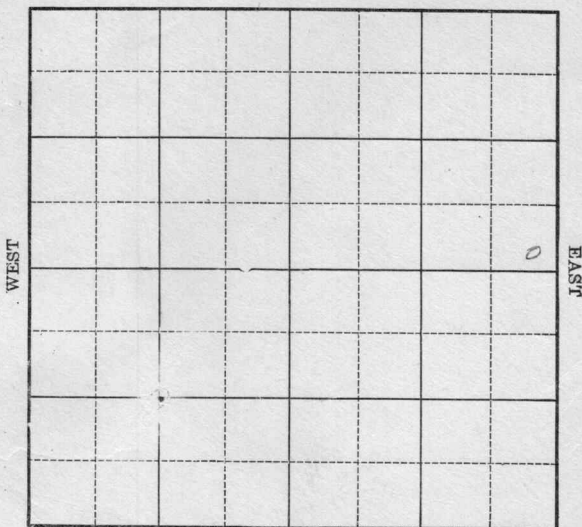

SOUTH

Location _____

Drilling Remarks _____

Rig Up _____

Drilling Remarks _____

RECORD

Cased _____ in. _____ ft.

Sand _____

Gas _____

Oil _____

Total Depth _____

PRODUCTION

1st 24 hrs. Nat. _____

1st 24 hrs. after shot _____

Gas _____ cu. ft.

Dry Hole _____

Abandoned _____

Greenwood

Map No. _____ Sec. 17 Twp. 24 R 13

Well No. 1 Hinemann Farm


J. L. Davis Company

_____ Ft. from N. Line

250 Ft. from S. Line

450 Ft. from E. Line

_____ Ft. from W. Line

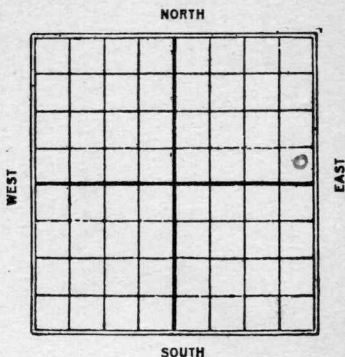Date
1/26

REPORT

3/3	Location
3/10	Machine
3/18	Rigging up.
3/25	Dlg 650
4/1	
4/7	S.S. 700
4/14	Dlg 850
4/21	Running 8" 1115'
4/30	Dlg 1230.
5/5	J.D. 1720 D-a. Boille
	1433-67 100/smell show.
	3p line 1708 Hfu.

Greenwood Co

Map No. KANSAS

Sec. 17

Twp. 24

R. 13

Well No. 1

Hinehan

J. S. Davis

Company

Contractor

SECTION PLAT

			o

Ft. from N. Line

250

Ft. from S. Line

450

Ft. from E. Line

Ft. from W. Line

FIRST REPORTS

Location ✓

Rig up

Drilling and Remarks:

RECORD

Cased _____ in., _____ ft.

Sand _____

Gas _____

Oil _____

Total Depth _____

PRODUCTION

1st 24 hrs. Nat. _____

1st 24 hrs. after shot _____

Gas _____ Cu. Ft.

Dry Hole _____

Abandoned _____

Date

MAR 3 1926

CHAS. L. SHERWOOD

192

Scout

no map
 Map No. **KANSAS** Sec. **17** Twp. **24** R. **13**

Well No. **1** **Hinchman**
J 5 **Davis** Company

Contractor

COMPLETED

SECTION PLAT

Ft. from N. Line

250 Ft. from S. Line

450 Ft. from E. Line

Ft. from W. Line

ABANDONED

Location

Rig up

Drilling and Remarks:

Drill 50 1433-67

100y small show

Top line 1708'

D & W 1720'

R.F.W.

RECORD

Cased _____ in., _____ ft.

Sand _____

Gas _____

Oil _____

Total Depth **1720'**

PRODUCTION

1st 24 hrs. Nat. _____

1st 24 hrs. after shot _____

Gas _____ Cu. Ft.

Dry Hole ☒ _____Abandoned ☒ _____

Date

MAY 5 1926

192

CHAS. L. SHERWOOD
 Scout