

Barton


FORM 51 5M BRIX

KANSAS

Section 7 Township 20 Range 15W

Well No. #1, S. Deckert

Company Amerada & Stanolind

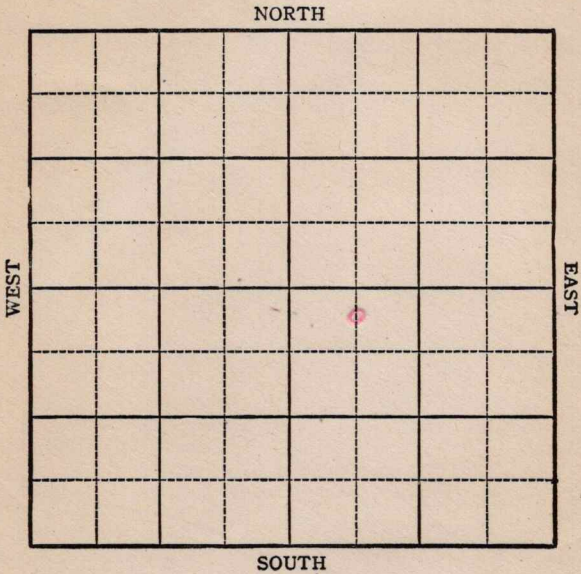


KANSAS

Barton

Sec. 7 Twp. 20 R. 15W

Well No. #1, S. Deckert Farm
Amerada & Stanolind Company

NORTH

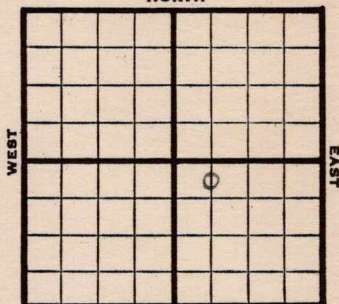

330 Ft. from N. Line

 Ft. from S. Line

 Ft. from E. Line

660 Ft. from W. Line

Elev. 2015

SOUTH

1944

REPORT

6/7	Location
6/15	RUR
6/21	8" @ 726 Drlg. 2503
6/28	Drlg. 3531
7/12	8 shots 3745-57 8 shots 3743-45 8 shots 3741-43 35' oil in 8 hrs 500 acid
7/19	Perf 3751-55 500 acid swb 4 oil per hr cut 16% W.
7/26	" " " " " " " " " " " "
8/2	Arb 3681 5" @ 3756 TD 3756 Perf Arb 1000 Acid Pump 58 Pot 36.4 Gravity


COMPLETED

KANSAS

Pool Name Pawnee Rock NEMap No. 82 Sec. 7 Twp. 20 R. 15WWell No. 1 S. DeckertAmerada & Stanolind CompanyFIRST REPORTC N L NW SE

Contractor

SECTION PLAT

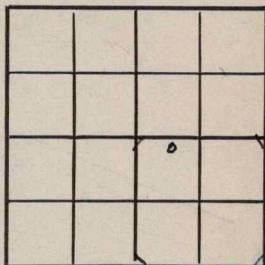330 Ft. from N. Line Ft. from S. Line Ft. from E. Line660 Ft. from W. LineBarton CountyLocation XRig up

Drilling and Remarks:

RECORD

Cased in., ft.Sand Gas Oil Total Depth

PRODUCTION

1st 24 hrs. Nat. 1st 24 hrs. after shot Gas Cu. Ft.Dry Hole Abandoned

Date

JUN 7 1944 19S. J. LEWIS Scout

KANSASPool Name Pawnee RockMap No. 82 Sec. 7 Twp. 20 R. 15WWell No. 1 S. Decker tAmerada & Stanolind Company**COMPLETED**

Contractor

C N L NW SE

SECTION PLAT

		0	

330 Ft. from N. Line Ft. from S. Line Ft. from E. Line660 Ft. from W. LineBarton CountyLocation Rig up

Drilling and Remarks:

*Per X 3681**5"-C 3756**Perf. Per X.**1800 acid**Pump 58 B & T**36 1/2***RECORD**Cased in., ft.Sand Gas Oil Total Depth 3756**PRODUCTION**1st 24 hrs. Nat. 1st 24 hrs. after shot Gas Cu. Ft.Dry Hole Abandoned

Date

AUG 2 1944 19S. J. LEWIS

Scout