


Section 21 Township 18 Range 1W

Well No. #2 State "C"

Company Glickman Oil Co.

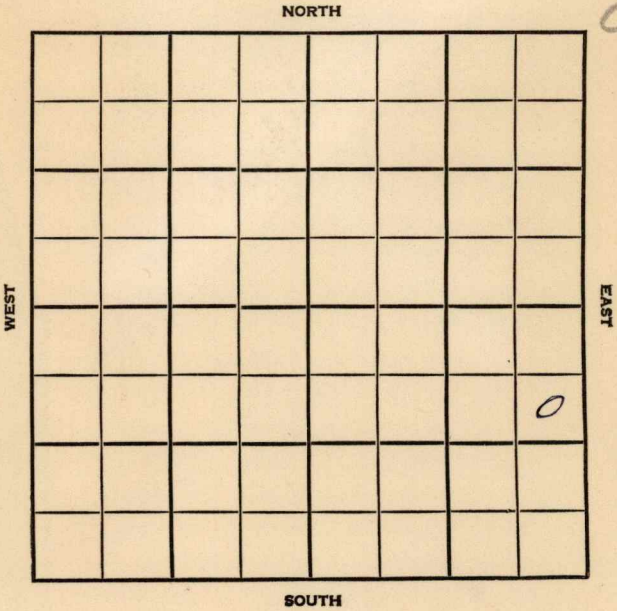

County Mc Pherson Elev. 1420 Co.
 Sec. 21 Twp. 18 Rge. 1W
 Company Glickman Oil Co.
 FarmName State "C" No. 2

TOPS	DEPTH	LOG	DATUM	Loc. in Sec.
Anh.				SE NE SE
TP.				
H.				
Tr.				
Dg.				
Bl.				
L.				
K.C.				Geol.
B.K.C.				Contr.
Ce.				Mallard Pools
C.				Pool
M. <u>chat</u>	<u>2750</u>			Paden
M. <u>Hunt</u>	<u>3147</u>			
K.				
Mz.				
Mo.				
V.	<u>3283</u>			<div style="border: 1px dashed black; padding: 5px; text-align: center;"> <p>COMPLETE</p> <p>NOV 23 '56</p> </div>
S.	<u>3352</u>			
S.				
A.	<u>3419</u>			
R.				
PE.				
G.				
FD.	<u>3870</u>			

Date Comm. spd. 11-1-56

8" @ 158 w/125, Drlg. 2150 NOV 13 '56

~~3470~~ 3662 NOV 21 '56 5 1/2 @

3470 DST 2774-82 1hr 10'

Md BHP 140 DST 3387-3400

1hr 5' Md BHP 1020/ PF.

20/3385-92 FU 3200'sw 1hr

co 3870 complete for

SWD well.

